

STATE OF KANSAS
STATE CORPORATION COMMISSION

WELL PLUGGING RECORD

Give All Information Completely
Make Required Affidavit
Mail or Deliver Report to:
Conservation Division
State Corporation Commission
800 Biting Building
Wichita, Kansas

Pawnee County. Sec. 34 Twp. 21S Rge. (E) 16 (W)

Location as "NE/CNW/SW" or footage from lines C SE NW SE

Lease Owner Gulf Oil Corporation

Lease Name M. A. Musselman Well No. 2

Office Address Box 661, Tulsa, Oklahoma

Character of Well (completed as Oil, Gas or Dry Hole) Dry Hole

Date well completed 1-6 1953

Application for plugging filed 6-14 1955

Application for plugging approved 6-14 1955


Plugging commenced 6-14 1955

Plugging completed 6-14 1955

Reason for abandonment of well or producing formation, Dry Hole

If a producing well is abandoned, date of last production _____ 19____

Was permission obtained from the Conservation Division or its agents before plugging was commenced? Yes

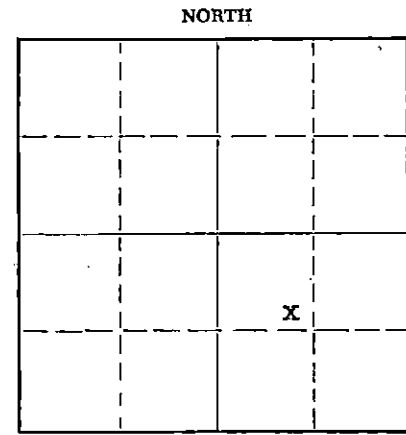

Locate well correctly on above Section Plat

Name of Conservation Agent who supervised plugging of this well M. A. Rives

Producing formation _____ Depth to top _____ Bottom _____ Total Depth of Well 1009 Feet

Show depth and thickness of all water, oil and gas formations.

OIL, GAS OR WATER RECORDS

CASING RECORD

FORMATION	CONTENT	FROM	TO	SIZE	PUT IN	PULLED OUT
				8-5/8"	983	-0-

Describe in detail the manner in which the well was plugged, indicating where the mud fluid was placed and the method or methods used in introducing it into the hole. If cement or other plugs were used, state the character of same and depth placed, from _____ feet to _____ feet for each plug set.

Pumped 5 barrels fresh mud into surface pipe at 300# by HOWCO, followed by HOWCO plug and 100 sacks Monarch Regular Portland Bulk Cement. Pumped plug to 708'. Mudded to 10' of surface, and capped with 10 sacks Atlas Regular Portland Cement filling into cellar.

(If additional description is necessary, use BACK of this sheet)

Name of Plugging Contractor None

Address _____

STATE OF Kansas, COUNTY OF Rice, ss.

Robert G. Bachtell (employee of owner) or (~~owner or operator~~) of the above-described well, being first duly sworn on oath, says: That I have knowledge of the facts, statements, and matters herein contained and the log of the above-described well as filed and that the same are true and correct. So help me God.

(Signature) R. G. Bachtell
Box 544, Chan, Kansas
(Address)

SUBSCRIBED AND SWORN TO before me this 17th day of June, 1955

My commission expires April 14, 1956

H. M. Council
Notary Public.

PLUGGING
FILE REC 347.21P.16W
BOOK PAGE 122 LINE 10

RECEIVED
STATE CORPORATION COMMISSION
JUN 19 1955
CONSERVATION DIVISION
Wichita, Kansas


STATE OF KANSAS
STATE CORPORATION COMMISSION

TEMPORARILY ABANDON

WELL PLUGGING RECORD

Give All Information Completely
Make Required Affidavit
Mail or Deliver Report to:
Conservation Division
State Corporation Commission
800 Bitting Building
Wichita, Kansas

NORTH

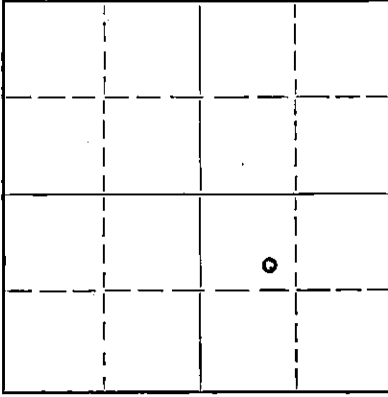

Locate well correctly on above
Section Plat

Pawnee County, Sec. 34 Twp. 21 S Rge. 16 (W)
Location as "NE/CNW $\frac{1}{4}$ SW $\frac{1}{4}$ " or footage from lines 990' SNL, 990' EML, SE/4
Lease Owner Gulf Oil Corporation
Lease Name M. A. Musselman Well No. 2
Office Address Box 661, Tulsa, Oklahoma
Character of Well (completed as Oil, Gas or Dry Hole) Dry Hole
Date well completed January 3, 1953
Application for plugging filed Verbal January 3, 1953
Application for plugging approved Verbal permission January 3, 1953
Plugging commenced January 7, 1953
Plugging completed January 7, 1953
Reason for abandonment of well or producing formation Dry Hole

If a producing well is abandoned, date of last production None 19
Was permission obtained from the Conservation Division or its agents before plugging was commenced? Verbal permission received from M. A. Rives Jan. 3, 1953

Name of Conservation Agent who supervised plugging of this well M. A. Rives
Producing formation Arbuckle Depth to top 3918 Bottom 4009 Total Depth of Well 4009 Feet
Show depth and thickness of all water, oil and gas formations.

OIL, GAS OR WATER RECORDS

CASING RECORD

Formation	Content	From	To	Size	Put In	Pulled Out
<u>Anhydrite</u>				<u>8-5/8"</u>	<u>971'</u>	<u>0</u>

Describe in detail the manner in which the well was plugged, indicating where the mud fluid was placed and the method or methods used in introducing it into the hole. If cement or other plugs were used, state the character of same and depth placed, from feet to feet for each plug set.

Hole filled with 44 Visc. 10 pound drilling mud from 4009' to top, installed swage and valve at top of surface pipe and retaining well for possible future salt water disposal well.

(If additional description is necessary, use BACK of this sheet)

Name of Plugging Contractor Barbour Drilling Company
Address 717 First National Bank Building
Tulsa, Oklahoma

STATE OF Kansas, COUNTY OF Rice, ss.
W. H. Duley (employee of owner) ~~or owner or operator~~ of the above-described well, being first duly sworn on oath, says: That I have knowledge of the facts, statements, and matters herein contained and the log of the above-described well as filed and that the same are true and correct. So help me God.

(Signature) W. H. Duley
Box 544, Chad, Ks. (Address)

SUBSCRIBED AND SWORN to before me this 30th day of March, 1953

My commission expires April 14, 1956 W. M. Council Notary Public.

WELL RECORD

GULF T 480-A PRINTED IN U.S.A.

15.145.00963.0000

COPY

WELL NO. 2 LEASE M. A. Musselman COMPANY Gulf Oil Corporation A.F.E. 3055

DATE—DRILLING BEGAN 12-19-52 WELL COMPLETED 1-6-53 FIRST PRODUCTION

SAND RECORD Dry Hole - Will retain for possible use as SWD well. TOTAL DEPTH 4009'

INITIAL PRODUCTION

CASING RECORD

SIZE	WEIGHT	THD.	CLASS	MAKE	SET AT DEPTH	SACKS CEMENT	LBS. CAL. CHLO.	PULLED	LEFT IN
8-5/8"	32	8V	B	Smls	983'	450			983'

S- 34 T- 21S R-16W

Center			
SE			
NW			
SE			
Pawnee County, Kansas			

Distance "H": From top of KB to top of collar on 8-5/8" Casing is 12'

ELEVATION— DF 1988'

Formation	From	To
Sand and Shale	0	71
Shale		420
Sand		510
Sand and Shale		745
Red bed and Lime Shells		810
Shale		984
Anhydrite		1002
Shale and Shells		1350
Shale		1790
Lime and Shale		1920
Shale and Lime		2075
Lime		2200
Lime and Shale		2305
Shale		2865
Shale and Lime		3135
Shale		3275
Lime		3830
Shale and Lime		3877
Lime		3885
Shale and Sand		3900
Shale		3909
Shale and Lime		3923
Arbuckle lime		4009
Total Depth		4009

COPY
6-14-55
:jrm

RECEIVED
STATE CORPORATION COMMISSION
JUN 16 1955
CONSERVATION DIVISION
Wichita, Kansas

PLUGGING
FILE SEC 34 7 2 A. How
BOOK PAGE 127 LINE 10