


STATE OF KANSAS
STATE CORPORATION COMMISSION

WELL PLUGGING RECORD

Give All Information Completely
Make Required Affidavit
Mail or Deliver Report to
Conservation Division
State Corporation Comm.,
245 North Water
Wichita, KS 67202

Pawnee County, Sec. 34 Twp. 21S Rge. 16W E/W
Location as "NE/CNW $\frac{1}{4}$ SW $\frac{1}{4}$ " or footage from lines

SE SE SW
Lease Owner Gulf Oil Corporation
Lease Name Musselman #3 Well No. _____
Office Address Bushton, Kansas 67427
Character of Well (Completed as Oil, Gas or Dry Hole) _____

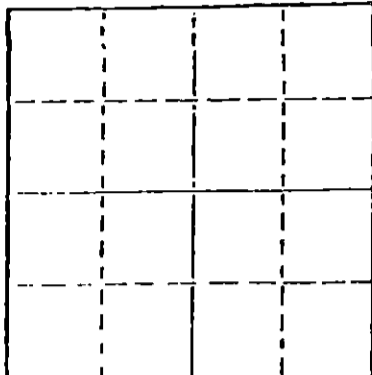

Locate well correctly on above
Section Plat

Date Well completed _____ 19____
Application for plugging filed _____ 19____
Application for plugging approved _____ 19____
Plugging commenced 3/30/77 _____ 19____
Plugging completed 4/5/77 _____ 19____
Reason for abandonment of well or producing formation
depleted.

If a producing well is abandoned, date of last production
_____ 19____

Was permission obtained from the Conservation Division or
its agents before plugging was commenced? yes

Name of Conservation Agent who supervised plugging of this well Massey
Producing formation _____ Depth to top _____ Bottom _____ Total Depth of Well 3875
Show depth and thickness of all water, oil and gas formations.

OIL, GAS OR WATER RECORDS

CASING RECORD

FORMATION	CONTENT	FROM	TO	SIZE	PUT IN	PULLED OUT
				8-5/8	994	none
				5 1/2"	3870	2521'

Describe in detail the manner in which the well was plugged, indicating where the mud fluid
was placed and the method or methods used in introducing it into the hold. If cement or other
plugs were used, state the character of same and depth placed, from _____ feet to
_____ feet for each plug set.

Checked hole, made bottom hole plug back with sand to 3850' and ran 4 sacks cement.
Shot pipe at 3200', 3000', 2805', 2610', 2515', pulled 78 joints. Mudded hole to 575'
and set 25' rock bridge from 575 to 550', filled hole with 8 yards ready mix from 550
to base of cellar.

PLUGGING COMPLETE.

(If additional description is necessary, use BACK of this sheet)


Name of Plugging Contractor KELSO CASING PULLING
CHASE, KANSAS

STATE OF KANSAS COUNTY OF RICE, ss.
R. Darrell Kelso (employee of owner) or (owner or operator)
of the above-described well, being first duly sworn on oath, says: That I have knowledge of
the facts, statements, and matters herein contained and the log of the above-described well
as filed and that the same are true and correct. So help me God.

(Signature) R. Darrell Kelso
Chase, Kansas
(Address)

SUBSCRIBED AND SWORN TO before me this 15th day of April, 19 77

My commission expires _____

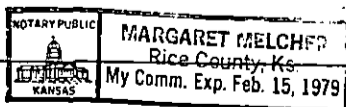

Margaret Melcher
Notary Public.

RECEIVED
STATE CORPORATION COMMISSION

APR 19 1977

CONSERVATION DIVISION
Wichita, Kansas

