

APR 2 - 1974

CONSERVATION DIVISION  
Wichita, Kansas


Form CP-4

STATE OF KANSAS  
STATE CORPORATION COMMISSION

Give All Information Completely  
Make Required Affidavit  
Mail or Deliver Report to  
Conservation Division  
State Corporation Commission

P. O. Box 17027  
Wichita, Kansas 67217

WELL PLUGGING RECORD

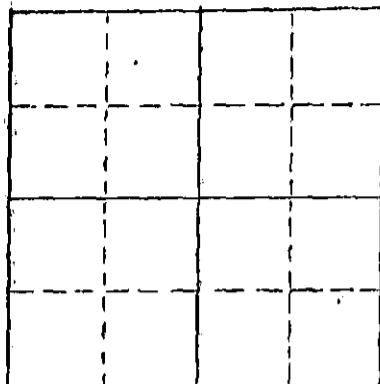

Locate well correctly on above  
Section Plat

Pawnee County, Sec. 34 Twp. 21 Rge. 16 (E) (W) X  
Location as "NE/CN/V/S/SW" or footage from lines NW SE NW  
Lease Owner A. L. Abercrombie, Inc.  
Lease Name Fairbanks Well No. #3  
Office Address 801 Union Center Wichita, Kansas  
Character of Well (completed as Oil, Gas or Dry Hole)  
Date well completed 19  
Application for plugging filed 19  
Application for plugging approved 19  
Plugging commenced 3-26-74 19  
Plugging completed 3-30-74 19  
Reason for abandonment of well or producing formation

If a producing well is abandoned, date of last production 19  
Was permission obtained from the Conservation Division or its agents before plugging was commenced?

Name of Conservation Agent who supervised plugging of this well Leo Massey  
Producing formation Depth to top Bottom Total Depth of Well 3848' Feet  
Show depth and thickness of all water, oil and gas formations.

OIL, GAS OR WATER RECORDS

CASING RECORD

| FORMATION | CONTENT | FROM | TO | SIZE   | PUT IN | PULLED OUT |
|-----------|---------|------|----|--------|--------|------------|
|           |         |      |    | 5 1/2" | 3841'  | 1967.32'   |
|           |         |      |    | 8 5/8" | 1000'  |            |
|           |         |      |    |        |        |            |
|           |         |      |    |        |        |            |
Describe in detail the manner in which the well was plugged, indicating where the mud fluid was placed and the method or methods used in introducing it into the hole. If cement or other plugs were used, state the character of same and depth placed, from feet to feet for each plug set.

Made bottom hole plug back with sand to 3775'. Mixed and ran 4 sacks cement thru dump bailer  
Mudded hole to 325' - set 25' rock bridge. Filled hole with 4 yards ready-mix concrete.


(If additional description is necessary, use BACK of this sheet)  
Name of Plugging Contractor, Southwest Casing Pulling Co.  
Address Box 364 Great Bend, Kansas

STATE OF Kansas COUNTY OF Barton ss.

Southwest Casing Pulling Co. (employee of owner) or (owner or operator) of the above-described well, being first duly sworn on oath, says: That I have knowledge of the facts, statements, and matters herein contained and the log of the above-described well is filed and that the same are true and correct. So help me God.

(Signature) W. C. Spencer Sec.  
Box 364 Great Bend, Kansas  
(Address)

Subscribed and sworn to before me this 1 day of April 19 74

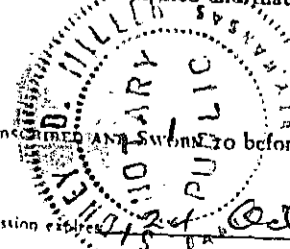

Siemey D. Miller  
Notary Public.

RECEIVED  
STATE CORPORATION COMMISSION  
DEC 17 1973  
CONSERVATION DIVISION  
Wichita, Kansas

CONTRACTOR'S WELL LOG

COMPANY: Musgrove Petroleum Corporation  
 CONTRACTOR: Musgrove Petroleum Corporation  
 FAHM: Fairbanks # 3  
 LOCATION: NW SE NW Section 34-21-16  
 Pawnee County, Kansas

COMMENCED: March 11, 1953  
 COMPLETED: March 24, 1953

|      |      |                           |
|------|------|---------------------------|
| 0    | 185  | Sand                      |
| 185  | 360  | Sand and shale            |
| 360  | 425  | Red bed                   |
| 425  | 540  | Sand                      |
| 540  | 975  | Red bed, shale and shells |
| 975  | 993  | Shale and shells          |
| 993  | 1008 | Anhydrite                 |
| 1008 | 1200 | Red bed and shale         |
| 1200 | 1415 | Shale and shells          |
| 1415 | 2250 | Shale and lime            |
| 2250 | 3125 | Shale and shells          |
| 3125 | 3504 | Lime and shale            |
| 3504 | 3625 | Lime                      |
| 3625 | 3842 | Lime and shale            |
| 3842 | 3848 | Artificial                |
|      | 3848 | Rotary Total Depth        |

Set 8 5/8" at 1000' with 400 sacks of cement.

Set 5 1/2" casing at 3842' with 150 sacks of cement.

STATE OF KANSAS }  
 COUNTY OF SEDGWICK } SS

I, GORDON L. KOELLING, do hereby certify that the above and foregoing is a true and correct copy of the log of the Fairbanks # 3, Section 34-21-16 Pawnee County, Kansas, as reflected by the files of the Musgrove Petroleum Corporation.

MUSGROVE PETROLEUM CORPORATION

By Gordon L. Koelling  
 Secretary-Treasurer

Subscribed and sworn to before me a Notary Public in and for Sedgwick County, Kansas, this 27th day of March, 1953.

Mary L. Quinn  
 Notary Public

My Commission Expires: November 14, 1956.