

STATE OF KANSAS  
STATE CORPORATION COMMISSION

WELL PLUGGING RECORD

OR


FORMATION PLUGGING RECORD

Strike out upper line when reporting plugging of formations.

Give All Information Completely  
Make Required Affidavit  
Mail or Deliver Report to:  
Conservation Division  
State Corporation Commission  
800 Biting Building  
Wichita, Kansas

Rice County. Sec. 16 Twp. 21 Rge. (E) 7 (W)  
Location as "NE 1/4 NW 1/4 SW 1/4" or footage from lines. NE 1/4 NW 1/4 SW 1/4  
Lease Owner. Mid Plains Oil Corporation  
Lease Name. C. F. Stange Well No. 2  
Office Address. 915 Union National Bank Bldg., Wichita, Kansas.  
Character of Well (completed as Oil, Gas or Dry Hole) Oil  
Date, well completed July 9, 19 37  
Application for plugging filed April 4, 19 45  
Application for plugging approved April 6, 19 45  
Plugging Commenced May 8, 19 45  
Plugging Completed May 15, 19 45  
Reason for abandonment of well or producing formation  
Unable to produce profitably any longer  
If a producing well is abandoned, date of last production May 15 19 45  
Was permission obtained from the Conservation Division or its agents before plugging was commenced? Yes

NORTH

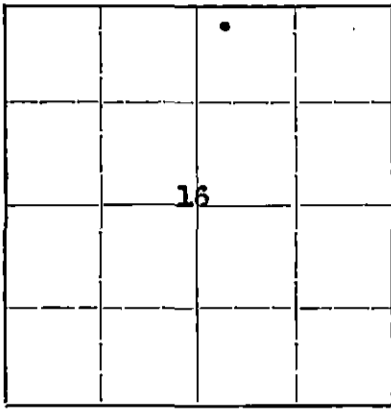

Locate well correctly on above Section Plat

Name of Conservation Agent who supervised plugging of this well. Ruell Durkee  
Producing formation. Conglomerate Depth to top. 3359 Bottom. 3378 Total Depth of Well. 3378 Feet  
Show depth and thickness of all water, oil and gas formations.


OIL, GAS OR WATER RECORDS

CASING RECORD

Formation	Content	From	To	Size	Put In	Pulled Out
Conglomerate	Oil & Gas	3359	3378	13" OD	95'	None
				7" OD	3374'	2733'
				5 1/2" OD	30'	None

Describe in detail the manner in which the well was plugged, indicating where the mud fluid was placed and the method or methods used in introducing it into the hole. If cement or other plugs were used, state the character of same and depth placed, from \_\_\_\_\_ feet to \_\_\_\_\_ feet for each plug set.

7 Sacks cement dumped at 3374'. Hole was filled with mud to 150' and 25 sacks cement gumped. Surface pipe was filled with mud and 8 sacks cement put in base of cellar.

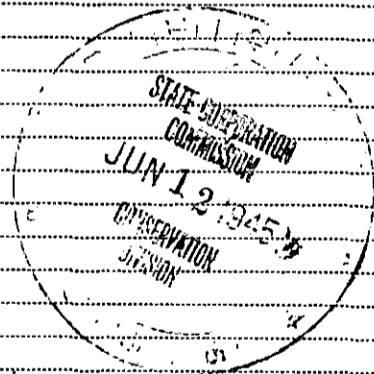

16 21 7W  
9 23

(If additional description is necessary, use BACK of this sheet)

Correspondence regarding this well should be addressed to. Mid Plains Oil Corporation, 915 Union National Bank Bldg., Wichita, Kansas.

STATE OF Kansas, COUNTY OF Sedgwick, ss.

I. John W. Ritchey (employee of owner) or (owner or operator) of the above-described well, being first duly sworn on oath, says: That I have knowledge of the facts, statements, and matters herein contained and the log of the above-described well as filed and that the same are true and correct. So help me God.

(Signature)

915 Union National Bank Bldg., Wichita, Kansas. (Address)

SUBSCRIBED AND SWORN to before me this 11th day of June 19 45

My commission expires

Jan 13 - 1949

Sarotha Star Carpenter Notary Public



FORMATION LOG

C. F. Stange Well #2  
 NW $\frac{1}{4}$  NE $\frac{1}{4}$  16-21-7W  
 Rice County, Kansas.

Sand	70
Red Bed Rock	100
Shale and Shells	350
Red Rock, Shale and Shells	615
Salt	965
Salt and Shale	1000
Lime	1065
Broken Lime	1140
Lime	1170
Broken Lime	1455
Lime	1515
Broken Lime	1600
Shale and Lime	1675
Shale and Shells	1790
Shale	2020
Shale and Shells	2380
Lime	2710
Broken Lime	2773
Shale and Lime	2864
Lime	2955
Broken Lime	2985
Lime	3255
Sand	3265
Red Rock	3272
Shale and Lime	3303
Shale and Shells	3338
Shale, Lime and Shells	3370
Red Rock	3371
Conglomerate	3372
Conglomerate	3445 TD

PT. 16-21-7W  
 9. 23

STATE CORPORATION  
 COMMISSIONER  
 JUN 10 1954