


WELL PLUGGING RECORD

Give All Information Completely
Make Required Affidavit
Mail or Deliver Report to:
Conservation Division
State Corporation Commission
800 Bitting Building
Wichita, Kansas

Rice County. Sec. 16 Twp. 21 Rge. (E) 7 (W)
Location as "NE/CNW $\frac{1}{4}$ SW $\frac{1}{4}$ " or footage from lines C SL NE 1/4 16-21-7W
Lease Owner Thos. H. Allan
Lease Name Stange Well No. 1
Office Address 1221 Union National Bank Bldg., Wichita 2, Kansas
Character of Well (completed as Oil, Gas or Dry Hole) Dry Hole
Date well completed October 19 1951
Application for plugging filed October 19 1951
Application for plugging approved October 19 1951
Plugging commenced October 19 1951
Plugging completed October 19 1951
Reason for abandonment of well or producing formation Dry

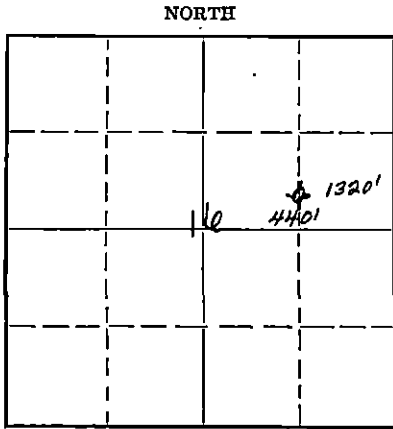

Locate well correctly on above Section Plat

If a producing well is abandoned, date of last production 19
Was permission obtained from the Conservation Division or its agents before plugging was commenced? Yes

Name of Conservation Agent who supervised plugging of this well Ruel Durkee
Producing formation Wherry Conglomerate Depth to top 3367' Bottom 3397' Plus Total Depth of Well 3397 Feet
Show depth and thickness of all water, oil and gas formations.

OIL, GAS OR WATER RECORDS

CASING RECORD

Formation	Content	From	To	Size	Put In	Pulled Out
				8 5/8"	145'	None
				5 1/2"	3369'	2858'

Describe in detail the manner in which the well was plugged, indicating where the mud fluid was placed and the method or methods used in introducing it into the hole. If cement or other plugs were used, state the character of same and depth placed, from _____ feet to _____ feet for each plug set.

- 3397 - 3365 Rock and 6 sacks cement
- 3365 - 140 Heavy Mud
- 140 - 100 Rock Bridge and 15 sacks cement
- 100 - 30 Heavy mud
- 30 - Surface 5 sacks cement

(If additional description is necessary, use BACK of this sheet)

Correspondence regarding this well should be addressed to Thos. H. Allan
Address 1221 Union National Bank Building, Wichita 2, Kansas

STATE OF KANSAS, COUNTY OF SEDGWICK, ss.

Thos. H. Allan (employee of/owner) or (owner or operator) of the above-described well, being first duly sworn on oath, says: That I have knowledge of the facts, statements, and matters herein contained and the log of the above-described well as filed and that the same are true and correct. So help me God.

(Signature) Thos. H. Allan

1221 Union Nat'l Bank Bldg., Wichita 2, Kansas (Address)

SUBSCRIBED AND SWORN TO before me this 25th day of October, 1951

Ocie M Stewart Notary Public.

My commission expires June 14, 1954

PLUGGING
FILE SEC-16T 8LR-72
BOOK PAGE 119 LINE 73

10-27-51 OCT 27 1951

Wichita, Kansas

15.159.03435.0000

8 5/8" @ 145' - 125 sx
5 1/2" @ 3369' - 75 sx
Pulled 2858' - 5 1/2"

ALLAN, et al - #1 STANGE
C SL NE/4 16-21-7W
Rice County, Kansas
Comm: 9/28/51 Compl: 10/19/51
CONTRACTOR: Tom Allan
ELEVATION: 1608 D. F.
1610 R. B.
I.P. D&A

DEPTH FROM ROTARY BUSHINGS.

0 -	.15	Surface Soil
	65	Sand & Gravel
	185	Red Beds
	440	Red & Green Shale
	690	Gray Shale
	1000	Salt & Shale
	1210	Shale & Anhydrite
	1240	Shale
	1300	Lime & Shale
	1340	Lime
	1400	Lime & Shale
	1430	Lime & Chert
	1800	Lime & Shale
	1830	Lime
	1930	Shale
	1990	Lime & Shale
	2050	Red & Gray Shale
	2090	Shale
	2150	Lime & Shale
	2180	Shale
	2210	Lime & Shale
	2270	Lime
	2330	Lime & Shale
	2370	Lime
	2430	Lime & Shale
	2550	Lime
	2630	Lime & Chert
	2740	Lime with Shale Breaks
	2770	Lime & Shale
	2840	Sand & Shale
	2880	Shale
	3015	Lime & Shale
	3055	Lime
	3145	Lime with Shale Breaks
	3280	Lime & Shale
	3367	Red & Gray Shale & Shells
	3370	(RTD) Varicolored Chert
	3370	Rotary = 3368 D.F. Cable Tools
	3377	D.F. Yellow Fossiliferous Chert
	3383	D.F. White weathered Chert Partly stained Red-Trace free Oil
	3385	D.F. Red & Green Shale
	3394	D.F. White Chert & little Oil Stained Tripoli - Little Free Oil
	3397	D. F. (TD) White & Yellow Chert some Dark Varicolored Chert

TESTING

Swab 93 gal. Oil in 7 hr 45 min or
12 gal. per hour
Shot 55 qts. Oil Well Explosive
3375-98
Swab 17 gal. Oil per hour

FORMATIONS:

Lansing 2904 R.B.
Cherty Conglomerate 3367 R.B.

I certify that the above is a true
and correct copy of the well log
on the above test.

Tom Allan

Subscribed and sworn to before me
this 25th day of October, 1951

Osie M Stewart
Notary Public

My Commission expires June 14, 1954

PLUGGING
FILE SEC 161 21 R 7W
BOOK PAGE 11 LINE 65