


STATE OF KANSAS
STATE CORPORATION COMMISSION

Give All Information Completely
Make Required Affidavit
Mail or Deliver Report to:
Conservation Division
State Corporation Commission
800 Bittling Building
Wichita, Kansas

WELL PLUGGING RECORD

McPherson County. Sec. 35 Twp. 21 Rge. 3 (X) W (W)
Location as "NE/CNW/SW" or footage from lines SW SW NW
Lease Owner E. K. Carey Drilling Co., Inc.
Lease Name J. W. Krehbiel "A" Well No. 1
Office Address Box 620, McPherson, Kansas
Character of Well (completed as Oil, Gas or Dry Hole) Dry hole
Date well completed June 28, 19 56
Application for plugging filed June 27, 19 56
Application for plugging approved June 27, 19 56
Plugging commenced 12 Midnight June 27, 19 56
Plugging completed 1:30 A.M. June 28, 19 56
Reason for abandonment of well or producing formation Dry hole

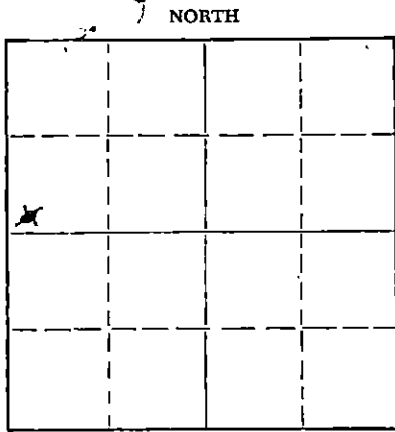

Locate well correctly on above
Section Plat

If a producing well is abandoned, date of last production 19
Was permission obtained from the Conservation Division or its agents before plugging was com-
menced? Yes

Name of Conservation Agent who supervised plugging of this well Ruel Durkee, McPherson, Kansas
Producing formation _____ Depth to top _____ Bottom _____ Total Depth of Well 3715 Feet
Show depth and thickness of all water, oil and gas formations.

OIL, GAS OR WATER RECORDS

CASING RECORD

FORMATION	CONTENT	FROM	TO	SIZE	PUT IN	PULLED OUT
				8-5/8"	243	None

Describe in detail the manner in which the well was plugged, indicating where the mud fluid was placed and the method or methods used in introducing it into the hole. If cement or other plugs were used, state the character of same and depth placed, from 243-228 feet to 20-5 feet for each plug set.

Ran Electric Log, ran half of drill pipe back in hole and came out laying down drill pipe. Ran rest of drill pipe in hole and genned pits and circulated heavy mud, layed down all but 8 joints drill pipe, ran measureing line to find fluid, fluid at 160', set plug at 243', put rock on top of plug and made bridge to hold weight of 8 joints drill pipe and cemented by Halliburton using 15 sacks. Layed down rest of drill pipe and filled with heavy mud to 20', set plug and mixed 5 sacks cement and filled to bottom of cellar floor. Through at 1:30 A.M. June 28, 1956

h-29-56

(If additional description is necessary, use BACK of this sheet)

Name of Plugging Contractor E. K. Carey Contractor
Address Box 620, McPherson, Kansas

STATE OF Kansas, COUNTY OF McPherson, ss.
Arland Bruce (employee of owner) or (owner or operator) of the above-described well, being first duly sworn on oath, says: That I have knowledge of the facts, statements, and matters herein contained and the log of the above-described well as filed and that the same are true and correct. So help me God.

(Signature) Arland Bruce.
Box 620, McPherson, Kansas
(Address)

SUBSCRIBED AND SWORN TO before me this 28th day of June, 1956

My commission expires November 13, 1956

[Signature]
Notary Public.

PLUGGING
FILE SEC 35 T 21 R 3W
BOOK PAGE 75 LINE 24

ROTARY DRILLING LOG

E. K. Carey Drilling Co., Inc.
Box 620
McPherson, Kansas

1456 F.S.
Elevations: 1454 D.F.
1451 Gr.

Krehbiel "A" #1

Casing Record:

C, W, S, F
Sec. 35-21-31
McPherson County, Kansas

8-5/8" @ 243' W/125 sks.
Pozmix cement and 300" cc.

Well Commenced: 6-13-56
Well Completed: 6-23-56 D & A

Contractor: E. K. Carey Contractor, Rig #1, Box 620, McPherson, Kansas
Geologist: Don Lollar, E. K. Carey Drilling Co., 318 Central Bldg., Wichita

Figures Indicate Bottom of Formation K. B.

cellar	0	Geologist Tops:	
shale	65	Lansing K.C.	2456
shale	240	Iss.	3141
shells	243	Wisner	3550
shale and lime	375	Linton	3559
shale	420	Paq.	3565
anhydrite	450	Simpson	3698
shale and lime	700	Rotary Total Depth	3715
shale	375		
lime and shale	1750	DSE - 3552 to 3559 or 6' anchor. Tool	
lime and shale	1810	open with no blow. Closed and open	
lime	2250	second time with no blow. Closed 20 m.	
sand and shale	2320	for T.P. Recovered 4' drilling mud, no	
shale and lime	2402	oil stains, HP 58%.	
lime	2745		
lime and shale	3141	DSE - 3557 to 3562 or 5' anchor. Tool	
lime (Iss.)	3445	open 15 m. with no blow. Closed 20 m.	
shale	3552	for HP. Recovered 3' mud. BHP 60%.	
sand (Wisner)	3559		
lime	3562		
lime and shale	3595		
shale and lime	3710		
lime	3715 TD		

This is to certify that the above information is to the best of my knowledge true and correct.

SUBSCRIBED AND SIGNED to be fore me this 23th day of June, 1956.

E. K. CAREY CONTRACTOR

BY Herbert Rhoton
Herbert Rhoton, Superintendent

Don Lollar
Don Lollar, Geologist

RP

My Commission Expires: November 13, 1956

PLUGGING		
FILE	SEC. <u>35</u>	T. <u>21</u> R. <u>3W</u>
BOOK	PAGE <u>15</u>	LINE <u>24</u>