

STATE OF KANSAS  
STATE CORPORATION COMMISSION


Give All Information Completely  
Make Required Affidavit  
Mail or Deliver Report to:  
Conservation Division  
State Corporation Commission  
211 No. Broadway  
Wichita, Kansas

WELL PLUGGING RECORD

McPherson County, Sec. 4 Twp. 21 Rge. (E) 3 (W)

Location as "NE/CNWxSWx" or footage from lines Aprx S/2 S/2 SW/4  
Lease Owner Donald T. Ingling et al  
Lease Name Felix Stucky Well No. 1  
Office Address Wichita, Kansas  
Character of Well (completed as Oil, Gas or Dry Hole) Dry Hole  
Date well completed June 26, 1966  
Application for plugging filed June 26, 1966  
Application for plugging approved June 26, 1966  
Plugging commenced June 26, 1966  
Plugging completed June 26, 1966  
Reason for abandonment of well or producing formation Dry

If a producing well is abandoned, date of last production 19\_\_\_\_  
Was permission obtained from the Conservation Division or its agents before plugging was commenced? Yes

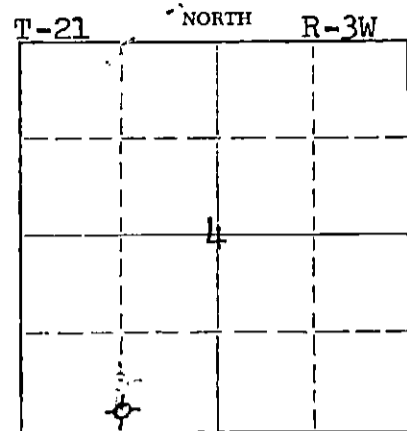

Locate well correctly on above Section Plat

Name of Conservation Agent who supervised plugging of this well Hugh Scott  
Producing formation \_\_\_\_\_ Depth to top \_\_\_\_\_ Bottom \_\_\_\_\_ Total Depth of Well 3800 Feet  
Show depth and thickness of all water, oil and gas formations.

OIL, GAS OR WATER RECORDS

CASING RECORD

FORMATION	CONTENT	FROM	TO	SIZE	PUT IN	PULLED OUT
				8 5/8"	224'	none

Describe in detail the manner in which the well was plugged, indicating where the mud fluid was placed and the method or methods used in introducing it into the hole. If cement or other plugs were used, state the character of same and depth placed, from \_\_\_\_\_ feet to \_\_\_\_\_ feet for each plug set.

Plug at 220 feet, 25 sacks cement and mud to 30 feet, plug at 30 feet, 10 sacks cement and mud to surface - 2 sacks cement in rat hole

RECEIVED  
STATE CORPORATION COMMISSION

JUL 1 1966

CONSERVATION DIVISION  
Wichita, Kansas

(If additional description is necessary, use BACK of this sheet)

Name of Plugging Contractor Donald T. Ingling  
Address Wichita, Kansas

STATE OF KANSAS, COUNTY OF SEDGWICK, ss.  
D. T. Ingling (employee of owner) or (owner or operator) of the above-described well, being first duly sworn on oath, says: That I have knowledge of the facts, statements, and matters herein contained and the log of the above-described well as filed and that the same are true and correct. So help me God.

(Signature) D. T. Ingling  
Wichita, Kansas (Address)

SUBSCRIBED AND SWORN to before me this 29th day of June, 1966

M. E. Black

My commission expires Feb. 27, 1968

Notary Public.

Donald T. Ingling et al, Lease Owner

Section 4-21-3W

Donald T. Ingling, Contractor

Location: Approx. C S/2 S/2 SW/4

Commenced: 6-12-66

Completed: 6-26-66

County: McPherson

Total Depth 3800'

Production: Dry

Casing: 8 5/8" 224' (135 sacks cement)

Elevation: 1476 RB

Figures below indicate bottom formation

40	surface shale	3535	lime and shale
160	shale and sand	3620	shale
200	shale	3653	shale
224	shale and shells	3680	lime
400	shale	3721	lime and shale
490	shale and shells	3736	Simpson sand
850	shale and lime	3743	sand
1035	lime and shale	3746	sand
1200	lime	3760	sand and shale
1425	shale and lime	3788	sand and shale
1750	shale and lime	3795	lime
1975	shale	3800	Arbuckle
2070	lime	3800	Total Depth
2175	lime and shale		
2280	lime		
2450	shale and sand		
2460	lime		
2575	lime		
2680	shale and lime		
2752	lime		
2827	lime		
2898	lime		
2970	lime and shale		
3055	lime and shale		
3145	shale		
3230	Conglomerate		
3250	Conglomerate and shale		
3295	Mississippi		
3375	Mississippi		
3411	Mississippi and shale		
3435	lime		
3470	lime		

RECEIVED  
STATE CORPORATION COMMISSION

JUL 1 1966

CONSERVATION DIVISION  
Wichita, Kansas

I certify this is a true and correct copy of the above mentioned well.

STATE OF KANSAS )  
                          ) ss.  
SEDGWICK COUNTY )

*[Signature]*

Subscribed and sworn to before me, a Notary Public, in said county and state.

*[Signature]*  
Notary Public

my commission expires: Feb. 27, 1968