


STATE OF KANSAS  
STATE CORPORATION COMMISSION

WELL PLUGGING RECORD

Give All Information Completely  
Make Required Affidavit  
Mail or Deliver Report to  
Conservation Division  
State Corporation Comm.  
245 North Water  
Wichita, KS 67202

McPherson County, Sec. 3 Twp. 21 Rge. 3W E/W  
Location as "NE/CNW $\frac{1}{4}$ /SW $\frac{1}{4}$ " or footage from lines  
W/2 NW NW

Lease Owner Kelso Casing Pulling  
Lease Name Stucky B#1 Well No. \_\_\_\_\_  
Office Address Box 176, Chase, Kansas 67524  
Character of Well (Completed as Oil, Gas or Dry Hole) \_\_\_\_\_

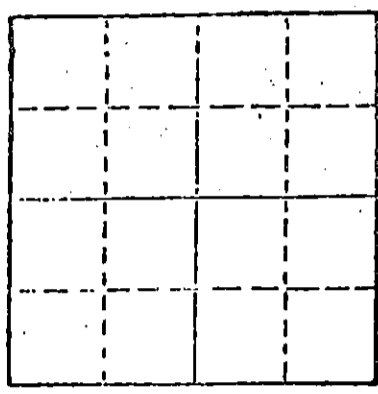

Date Well completed \_\_\_\_\_ 19\_\_\_\_  
Application for plugging filed \_\_\_\_\_ 19\_\_\_\_  
Application for plugging approved \_\_\_\_\_ 19\_\_\_\_  
Plugging commenced 7/11/80 \_\_\_\_\_ 19\_\_\_\_  
Plugging completed 7/15/80 \_\_\_\_\_ 19\_\_\_\_  
Reason for abandonment of well or producing formation  
depleted.

If a producing well is abandoned, date of last production  
\_\_\_\_\_ 19\_\_\_\_

Was permission obtained from the Conservation Division or  
its agents before plugging was commenced? yes

Name of Conservation Agent who supervised plugging of this well Toman  
Producing formation \_\_\_\_\_ Depth to top \_\_\_\_\_ Bottom \_\_\_\_\_ Total Depth of Well 3466  
Show depth and thickness of all water, oil and gas formations.

OIL, GAS OR WATER RECORDS

CASING RECORD

FORMATION	CONTENT	FROM	TO	SIZE	PUT IN	PULLED OUT
				8-5/8	225	none
				4 1/2"	3466	2216'

Describe in detail the manner in which the well was plugged, indicating where the mud fluid was placed and the method or methods used in introducing it into the hold. If cement or other plugs were used, state the character of same and depth placed, from \_\_\_\_\_ feet to \_\_\_\_\_ feet for each plug set.

Sanded to 3400' and ran 3 sacks cement. Shot pipe at 2313', 2231', worked pipe loose and pulled 55 joints. Bailed hole to 260' and set rock bridge from 260 to 245', ran 4 1/2 yards ready mix.

PLUGGING COMPLETE.

(If additional description is necessary, use BACK of this sheet)

Name of Plugging Contractor KELSO CASING PULLING  
CHASE, KANSAS

STATE OF KANSAS COUNTY OF RICE, ss.  
R. DARRELL KELSO (employee of owner) or (owner or operator)

of the above-described well, being first duly sworn on oath, says: That I have knowledge of the facts, statements, and matters herein contained and the log of the above-described well as filed and that the same are true and correct. So help me God.

(Signature) R Darrell Kelso  
CHASE, KANSAS (Address)

SUBSCRIBED AND SWORN TO before me this 17th day of July, 19 80

My commission expires \_\_\_\_\_

Margaret Melcher  
Notary Public.

RECEIVED  
STATE CORPORATION COMMISSION

JUL 18 1980

CONSERVATION DIVISION  
Wichita, Kansas