

# WELL PLUGGING RECORD


STATE OF KANSAS  
STATE CORPORATION COMMISSION

Give All Information Completely  
Make Required Affidavit  
Mail or Deliver Report to:  
Conservation Division  
State Corporation Commission  
800 Bittling Building  
Wichita, Kansas

## FORMATION PLUGGING RECORD

Strike out upper line  
when reporting plugging  
of formations.

Location as "NE $\frac{1}{4}$ NW $\frac{1}{4}$ SW $\frac{1}{4}$ " or footage from lines Ellis County. Sec. 20 Twp. 15 Rge. (E) 18 (W)  
 Lease Owner A-B-W  
 Lease Name Klaus Well No. 1  
 Office Address Wiesner Bldg., Hays, Kansas  
 Character of Well (completed as Oil, Gas or Dry Hole) Dry hole  
 Date well completed 6-29-49 19\_\_  
 Application for plugging filed Yes 19\_\_  
 Application for plugging approved Yes 19\_\_  
 Plugging commenced 8:00 A. M. 6-30-49 19\_\_  
 Plugging completed 10:00 A. M. 6-30-49 19\_\_  
 Reason for abandonment of well or producing formation dry

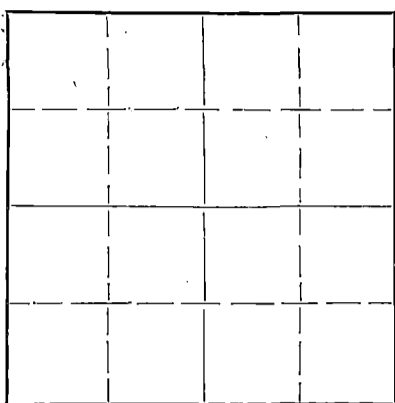

Locate well correctly on above  
Section Plat

If a producing well is abandoned, date of last production.....19\_\_  
 Was permission obtained from the Conservation Division or its agents before plugging was commenced?.....telephone

Name of Conservation Agent who supervised plugging of this well C. D. Stough  
 Producing formation..... Depth to top..... Bottom..... Total Depth of Well 356 Feet  
 Show depth and thickness of all water, oil and gas formations.

### OIL, GAS OR WATER RECORDS

### CASING RECORD

| Formation   | Content | From | To | Size | Put In | Pulled Out |
|---|---------|------|----|------|--------|------------|
| cemented 600 sax<br>bulk cement which<br>returned |         |      |    |      |        |            |
|   |         |      |    |      |        |            |
|   |         |      |    |      |        |            |
|   |         |      |    |      |        |            |

Describe in detail the manner in which the well was plugged, indicating where the mud fluid was placed and the method or methods used in introducing it into the hole. If cement or other plugs were used, state the character of same and depth placed, from.....feet to.....feet for each plug set.

stirred pits and filled hole with heavy mud from  
bottom to 200 ft.  
Placed wooden plug put 15 sax cement filled hole  
to 30' heavy mud - used wooden plug and 10 sax  
cement

**RECEIVED**  
Conservation Div.  
JUL - 6 1949  
STATE CORPORATION  
COMMISSION  
KANSAS

(If additional description is necessary, use BACK of this sheet)

Correspondence regarding this well should be addressed to A-B-W  
 Address.....

STATE OF....., COUNTY OF....., ss.  
 \_\_\_\_\_ (employee of owner) or (owner or operator) of the above-described well,  
 being first duly sworn on oath, says: That I have knowledge of the facts, statements, and matters herein contained and the log of the above-described well as filed and that the same are true and correct. So help me God.


(Signature) H. D. Sweetman

(Address)

SUBSCRIBED AND SWORN TO before me this 30 day of June, 19 49

Margaret Ring  
Notary Public.

My commission expires April 22 50

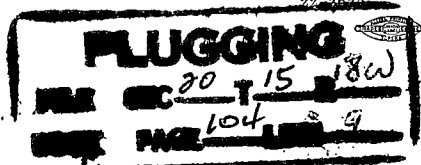

**A-B-W DRILLING COMPANY, INC.**

Box 615 — Eddy Building  
HAYS, KANSAS

Invoice No. \_\_\_\_\_

WELL LOG

TO:

Klaus #1

Date \_\_\_\_\_

Location: NW/4 Section 20 - 15 - 18, Ellis County, Kansas

LEASE

Commenced June 15, 1949  
Completed June 30, 1949

|                        |               |
|------------------------|---------------|
| Shale and Shells       | 0 - 160       |
| Shale and shells       | 160 - 290     |
| Shael and shells       | 290 - 415     |
| Shale and shells       | 415 - 455     |
| Sand                   | 455 - 470     |
| Shale and sand         | 470 - 510     |
| Shale and shells       | 510 - 565     |
| Sand                   | 565 - 760     |
| Red Bed                | 760 - 825     |
| Red Bed                | 825 - 915     |
| Red Bed and Shells     | 915 - 1,020   |
| Red Bed and Shells     | 1,020 - 1,109 |
| Anhydrite              | 1,109 - 1,150 |
| Shale, Salt and Shells | 1,150 - 1,345 |
| Shale and Shells       | 1,345 - 1,540 |
| Salt                   | 1,540 - 1,610 |
| Salt                   | 1,610 - 1,780 |
| Shale and Shells       | 1,780 - 1,815 |
| Shale and Lime         | 1,815 - 1,950 |
| Lime                   | 1,950 - 2,050 |
| Lime and Shale         | 2,050 - 2,165 |
| Lime                   | 2,165 - 2,265 |
| Shale and Lime         | 2,265 - 2,325 |
| Shale and Lime         | 2,325 - 2,430 |
| Shale and Lime         | 2,430 - 2,535 |
| Shale and Lime         | 2,535 - 2,635 |
| Shale and Lime         | 2,635 - 2,775 |
| Shale and Lime         | 2,775 - 2,890 |
| Shale and Lime         | 2,890 - 2,955 |
| Shale and Lime         | 2,955 - 3,009 |
| Lime                   | 3,009 - 3,079 |
| Lime                   | 3,079 - 3,121 |
| Lime                   | 3,121 - 3,186 |
| Lime                   | 3,186 - 3,235 |
| Lime                   | 3,235 - 3,277 |
| Lime                   | 3,277 - 3,310 |
| Lime                   | 3,310 - 3,365 |
| Lime                   | 3,365 - 3,404 |
| Lime                   | 3,404 - 3,470 |
| Lime                   | 3,470 - 3,513 |
| Conglomerate           | 3,513 - 3,522 |
| Conglomerate           | 3,522 - 3,555 |
| Arbuckle Lime          | 3,555 - 3,564 |
| TOTAL DEPTH            | 3,564         |

CASING RECORD

8-5/8" O.D. - 24 Lb. Surface casing set at 1,109 Feet. Cemented with 600 sacks of bulk cement.

RECORDED  
Conservation Div.

JUL - 6-1949

STATE CORPORATION COMMISSION KANSAS

STATE OF KANSAS

SS:

COUNTY OF ELLIS

I hereby affirm that the above and foregoing is a true and correct copy of the log of Klaus well #1 located in the NW/4 of section 20 - 15 - 18, Ellis County, Kansas.

A-B-W DRILLING COMPANY

**PLUSSING**  
NOV 15 1949  
104 9

By: Fred B. Anschutz

Subscribed and sworn to before me, a Notary Public, this July 1 day of

July, 1949.

Margaret Reay  
Notary Public

My commission expires April 22 '50