


WELL PLUGGING RECORD

Give All Information Completely
Make Required Affidavit
Mail or Deliver Report to:
Conservation Division
State Corporation Commission
211 No. Broadway
Wichita, Kansas

NORTH

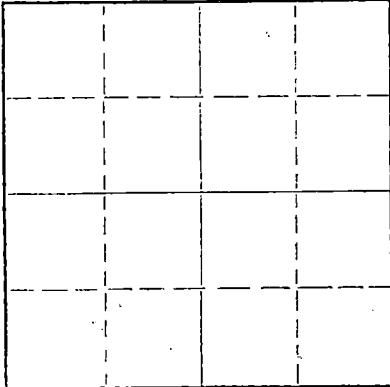

Locate well correctly on above
Section Plat

Ellis County. Sec. 3 Twp. 15S Rge. 18W (EX) (W)
Location as "NE/CNW/SW" or footage from lines SE SE NW
Lease Owner Herman George Kaiser, Oil Producer
Lease Name Ruder Well No. E-#1
Office Address 909 Palace Building, Tulsa, Oklahoma
Character of Well (completed as Oil, Gas or Dry Hole) Dry Hole
Date well completed 10-6-63 19
Application for plugging filed 10-6-63 19
Application for plugging approved 10-6-63 19
Plugging commenced 10-6-63 19
Plugging completed 10-6-63 19
Reason for abandonment of well or producing formation Dry Hole

If a producing well is abandoned, date of last production 19
Was permission obtained from the Conservation Division or its agents before plugging was commenced? Yes

Name of Conservation Agent who supervised plugging of this well Eldon Petty, Hays, Kansas
Producing formation _____ Depth to top _____ Bottom _____ Total Depth of Well 3617 Feet
Show depth and thickness of all water, oil and gas formations.

OIL, GAS OR WATER RECORDS

CASING RECORD

| FORMATION | CONTENT | FROM | TO | SIZE | PUT IN | PULLED OUT |
|-----------|---------|------|----|--------|--------|------------|
| | | | | | | |
| | | | | 8 5/8" | 224' | none |
| | | | | | | |
| | | | | | | |

Describe in detail the manner in which the well was plugged, indicating where the mud fluid was placed and the method or methods used in introducing it into the hole. If cement or other plugs were used, state the character of same and depth placed, from _____ feet to _____ feet for each plug set.

Fill hole with heavy mud. Sun Oilwell Cementing pumped in 125 sacks Cement.

RECEIVED
STATE CORPORATION COMMISSION

OCT 9 1963

CONSERVATION DIVISION
Wichita, Kansas

(If additional description is necessary, use BACK of this sheet)

Name of Plugging Contractor Leben Drilling, Inc.
Address P. O. Box 486, Great Bend, Kansas

STATE OF KANSAS, COUNTY OF BARTON, ss.
Leslie Kite (employee of owner) or (owner or operator) of the above-described well, being first duly sworn on oath, says: That I have knowledge of the facts, statements, and matters herein contained and the log of the above-described well as filed and that the same are true and correct. So help me God.

(Signature) Leslie Kite
P. O. Box 486, Great Bend, Kansas
(Address)

SUBSCRIBED AND SWORN to before me this 7th day of October, 1963

My commission expires April 1, 1967 Ulanda Nichols Notary Public.

DRILLER'S LOG

COMPANY: Herman George Kaiser
Oil Producer
CONTRACTOR: LEBEN DRILLING, INC.
FARM: RUDER E-#1
LOCATION: SE SE NW Sec. 3-15S-18W
ELLIS COUNTY, KANSAS
COMMENCED: 9-30-63
COMPLETED: 10-6-63

| | | |
|------|-------------|---|
| 0 | 110 | Shale |
| 110 | 1150 | Shale & Shells |
| 1150 | 1198 | Shale |
| 1198 | 1240 | Anhydrite |
| 1240 | 1565 | Shale & Shells |
| 1565 | 1995 | Shale & Lime |
| 1995 | 2130 | Lime |
| 2130 | 2305 | Shale & Lime |
| 2305 | 2635 | Lime & Shale |
| 2635 | 2930 | Shale & Shells |
| 2930 | 3100 | Shale & Lime |
| 3100 | 3295 | Lime |
| 3295 | 3395 | Shale & Lime |
| 3395 | 3617 | Lime |
| | <u>3617</u> | <u>Rotary Total Depth - D. & A.</u> |

RECEIVED
STATE CORPORATION COMMISSION

OCT 9 1963

CONSERVATION DIVISION
Wichita, Kansas

Set 8 5/8" used Surface Casing @ 224' Cemented with 160 sacks Sunset.

I, Leslie Kite, do hereby certify that the above and foregoing is a true and correct copy of the log of the Ruder E-#1 well, located SE SE NW of Section 3, Township 15 South, 18 West, Ellis County, Kansas, as reflected by the files of Leben Drilling, Inc.

Leslie Kite

Leslie Kite

STATE OF KANSAS)
) SS
COUNTY OF BARTON)

Subscribed and sworn to before me, a Notary Public, in and for Barton County, Kansas, this 7th day of October, 1963.

Ulanda Nichols

Ulanda Nichols, Notary Public

My Commission Expires:
April 1, 1967