


STATE OF KANSAS
STATE CORPORATION COMMISSION

Form CP-4

Give All Information Completely
Make Required Affidavit
Mail or Deliver Report to:
Conservation Division
State Corporation Commission
212 No. Market
Wichita, Kansas

WELL PLUGGING RECORD

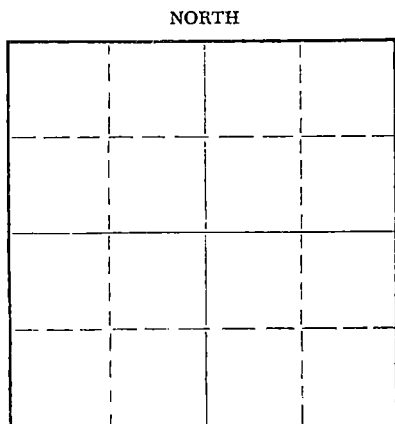

Locate well correctly on above
Section Plat

ELLIS County. Sec. 2 Twp. 15S Rge. (E) 18 (W)
Location as "NE/CNW/SW" or footage from lines N 1/2 SE NW
Lease Owner EDWARD P. LEIKER
Lease Name LEIKER "A" Well No. 2
Office Address MUNJOR ROUTE, BOX 17, HAYS, KANSAS
Character of Well (completed as Oil, Gas or Dry Hole) DRY HOLE
Date well completed 4-6- 19 67
Application for plugging filed (LETTER 4-18-67) 4-6- 19 67
Application for plugging approved 4-6- 19 67
Plugging commenced 4-6- 19 67
Plugging completed 4-6- 19 67
Reason for abandonment of well or producing formation

If a producing well is abandoned, date of last production 19
Was permission obtained from the Conservation Division or its agents before plugging was commenced? YES

Name of Conservation Agent who supervised plugging of this well LEO MASSEY
Producing formation Depth to top Bottom Total Depth of Well 220 Feet
Show depth and thickness of all water, oil and gas formations.

OIL, GAS OR WATER RECORDS

CASING RECORD

FORMATION	CONTENT	FROM	TO	SIZE	PUT IN	PULLED OUT
		0	151	8-5/8	151'	NONE

Describe in detail the manner in which the well was plugged, indicating where the mud fluid was placed and the method or methods used in introducing it into the hole. If cement or other plugs were used, state the character of same and depth placed, from feet to feet for each plug set.

FILLED HOLE WITH HEAVY MUD TO 145 FEET. SET FIRST PLUG @ 145 FEET WITH 1/4 SACK HULLS AND 25 SACKS CEMENT. FILLED HOLE WITH HEAVY MUD TO 40 FEET. SET SECOND PLUG WITH 1/4 SACK HULLS AND 10 SACKS CEMENT. JOB COMPLETE 11:00 AM, 4-6-67.

RECEIVED
APR 20 1967
CONSERVATION DIVISION
Wichita, Kansas

(If additional description is necessary, use BACK of this sheet)
Name of Plugging Contractor GABBERT-JONES, INC.
Address 830 SUTTON PLACE, WICHITA, KANSAS

STATE OF KANSAS, COUNTY OF SEDGWICK, ss.
E. E. HALL (employee of owner) or (owner or operator) of the above-described

well, being first duly sworn on oath, says: That I have knowledge of the facts, statements, and matters herein contained and the log of the above-described well as filed and that the same are true and correct. So help me God.

(Signature) E. E. Hall
830 SUTTON PLACE, WICHITA, KANSAS
(Address)

SUBSCRIBED AND SWORN TO before me this 18 day of APRIL, 19 67

My commission expires FEBRUARY 1, 1968

Barbara J. Layton
BARBARA J. LAYTON Notary Public.

