


STATE OF KANSAS  
STATE CORPORATION COMMISSION

Give All Information Completely  
Make Required Affidavit  
Mail or Deliver Report to:  
Conservation Division  
State Corporation Commission  
211 No. Broadway  
Wichita, Kansas

WELL PLUGGING RECORD

NORTH

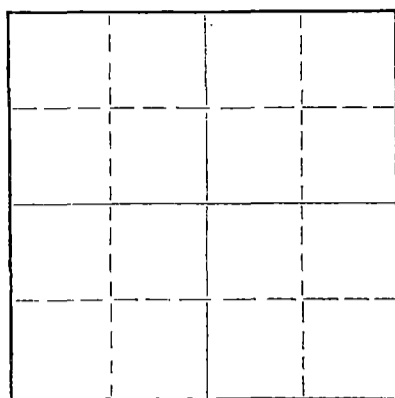

Locate well correctly on above  
Section Plat

Stafford County, Sec. 4 Twp. 21 Rge. (E) 13(W)  
Location as "NE/CNW/SW" or footage from lines NW - SE - SE  
Lease Owner Herman George Kaiser  
Lease Name Wilcutt "B" Well No. 1  
Office Address Ellinwood, Kansas  
Character of Well (completed as Oil, Gas or Dry Hole) \_\_\_\_\_  
Date well completed \_\_\_\_\_ 19\_\_\_\_  
Application for plugging filed \_\_\_\_\_ 19\_\_\_\_  
Application for plugging approved \_\_\_\_\_ 19\_\_\_\_  
Plugging commenced May 7 1958  
Plugging completed May 13 1958  
Reason for abandonment of well or producing formation \_\_\_\_\_

If a producing well is abandoned, date of last production \_\_\_\_\_ 19\_\_\_\_  
Was permission obtained from the Conservation Division or its agents before plugging was commenced? Yes

Name of Conservation Agent who supervised plugging of this well Frank Brodfoot  
Producing formation \_\_\_\_\_ Depth to top \_\_\_\_\_ Bottom \_\_\_\_\_ Total Depth of Well \_\_\_\_\_ Feet  
Show depth and thickness of all water, oil and gas formations.


OIL, GAS OR WATER RECORDS

CASING RECORD

FORMATION	CONTENT	FROM	TO	SIZE	PUT IN	PULLED OUT
				8 5/8	286	None
				5 1/2	3405	2793.44

Describe in detail the manner in which the well was plugged, indicating where the mud fluid was placed and the method or methods used in introducing it into the hole. If cement or other plugs were used, state the character of same and depth placed, from \_\_\_\_\_ feet to \_\_\_\_\_ feet for each plug set.

Sanded to 3265' - dumped 5 sks cement - mudded hole to 240'  
set 10' rock bridge - dumped 2 sks Cal Seal and 1 sk cement - let set one  
hour - bailed dry - dumped 14 sks cement - mudded to 40' - set 10' rock  
bridge - dumped 10 sks cement.

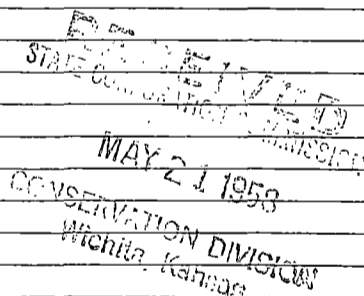

(If additional description is necessary, use BACK of this sheet)  
Name of Plugging Contractor R & D Casing Pulling Company License # 236  
Address Box 569 Ellinwood, Kansas


STATE OF Kansas, COUNTY OF Barton, ss.  
I, W. J. Hall (employee of owner) or (owner or operator) of the above-described well, being first duly sworn on oath, says: That I have knowledge of the facts, statements, and matters herein contained and the log of the above-described well as filed and that the same are true and correct. So help me God.

(Signature) W. J. Hall

SUBSCRIBED AND SWORN TO before me this 16 day of May, 19 58

(Address) \_\_\_\_\_  
Delmer L. Postner  
Notary Public.

My commission expires \_\_\_\_\_

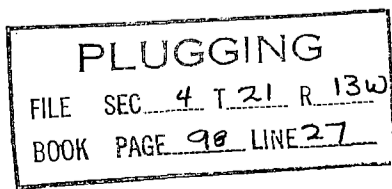

WELDRING BUREAU - KANSAS GEOLOGICAL SURVEY  
 412 Union National Bk Bldg., Wichita, Kansas


15.185.616.73.0000

BODINE-FAULKNER-WINDMULLER  
 Wellcut No. 1.

SEC. 4 T. 21 R. 13W  
 NW SE SE

Total Depth. 3413'  
 Comm. 7-5-41 Comp. 7-25-41  
 Shot or Treated. 8000 Gals. Acid  
 Contractor.  
 Issued. 8-16-41

County. Stafford

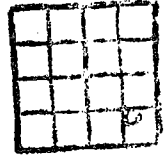

CASING:

8 5/8" 286' Com.  
 5 1/2" 3405' Com.

Elevation.

Production. Pot. 3000 B.

Figures Indicate Bottom of Formations.

sand sft	105
sand hrd	130
sand rock	140
iron & sand rock	155
shale	235
sand	270
shale	280
red bed & shells	610
anhydrite	670
shale & shells	960
salt	1155
shale & shells	1245
lime	1630
lime sdy	1835
lime & shale	1920
sand	1955
lime	2000
lime & shale	2050
lime sdy	2060
shale & lime	2085
lime	2210
shale & shells	2480
lime & shale	2560
shale & shells	2670
lime & shale	2745
lime	2975
lime & shale	3125
lime brkn	3210
shale & shells	3268
lime	3290
shale	3385
lime & shale	3400
cored	3402
shale cored	3405
lime	3410
reamed 3400-10	
lime	3413
Total Depth.	

*P. B 3409'*

RECEIVED  
 STATE GEOLOGICAL COMMISSION

MAY 6 1958

OPERATION DIVISION  
 Wichita, Kansas

PLUGGING  
 FILE SEC 4 T. 21 R. 13W  
 BOOK PAGE 98 LINE 27