


STATE OF KANSAS
 STATE CORPORATION COMMISSION

Give All Information Completely
 Make Required Affidavit
 Mail or Deliver Report to:
 Conservation Division
 State Corporation Commission
 800 Biting Building
 Wichita, Kansas

OR
FORMATION PLUGGING RECORD Strike out upper line when reporting plugging off formations.

Stafford County. Sec. 4 Twp 21S Rge. (E) 13 (W)
 Location as "NE $\frac{1}{4}$ NW $\frac{1}{4}$ SW $\frac{1}{4}$ " or footage from lines. C-S/2-SE/4-NE/4
 Lease Owner: The Atlantic Refining Company
 Lease Name: Sharp Well No. 1
 Office Address: P. O. Box 17, Great Bend, Kansas
 Character of Well (completed as Oil, Gas or Dry Hole): Oil
 Date well completed: June 23, 1941
 Application for plugging filed: April 6, 1945
 Application for plugging approved: April 11, 1945
 Plugging commenced: July 31, 1946
 Plugging completed: August 7, 1946
 Reason for abandonment of well or producing formation: Depleted formation

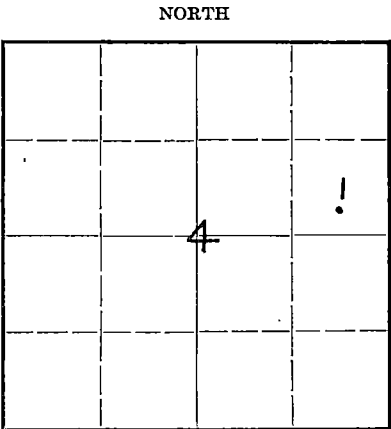

Locate well correctly on above Section Plat

If a producing well is abandoned, date of last production: May 1, 1946
 Was permission obtained from the Conservation Division or its agents before plugging was commenced? Yes

Name of Conservation Agent who supervised plugging of this well: H. W. Kerr
 Producing formation: Lansing - Kansas City Depth to top: 3402 Bottom: 3412 Total Depth of Well: 3412 Feet
 Show depth and thickness of all water, oil and gas formations.

OIL, GAS OR WATER RECORDS

CASING RECORD

| Formation | Content | From | To | Size | Put In | Pulled Out |
|-----------|-------------|------|------|--------|--------|------------|
| Lansing | Oil & Water | 3282 | 3412 | 8-5/8" | 254 | None |
| | | | | 5-1/2" | 3402 | 1795' |
| | | | | | | |
| | | | | | | |
| | | | | | | |
| | | | | | | |
| | | | | | | |
| | | | | | | |
| | | | | | | |

Describe in detail the manner in which the well was plugged, indicating where the mud fluid was placed and the method or methods used in introducing it into the hold. If cement or other plugs were used, state the character of same and depth placed, from _____ feet to _____ feet for each plug set.

Cement from 3412 to 3362
 Mud from 3362 to 250
 Cement from 150 to 102
 Mud from 102 to 10
 Cement from 10 to surface

8-10-46

4 21 130
 9 38

(If additional description is necessary, use BACK of this sheet)

Correspondence regarding this well should be addressed to: The Atlantic Refining Company
 Address: P. O. Box 17, Great Bend, Kansas

STATE OF Kansas, COUNTY OF Barton, ss.
 Stanton K. Myers (employee of owner) or (owner or operator) of the above-described well, being first duly sworn on oath, says: That I have knowledge of the facts, statements, and matters herein contained and the log of the above-described well as filed and that the same are true and correct. So help me God.

(Signature) *Stanton K. Myers*

(Address)

SUBSCRIBED AND SWORN to before me this 8th day of August, 1946.

H. C. Colegrover
 Notary Public.

My commission expires October 28, 1948