


STATE OF KANSAS
STATE CORPORATION COMMISSION

WELL PLUGGING RECORD

FORMATION PLUGGING RECORD

Give All Information Completely
Make Required Affidavit
Mail or Deliver Report to:
Conservation Division
State Corporation Commission
800 Bittling Building
Wichita, Kansas

Strike out upper line
when reporting plugging
of formations.

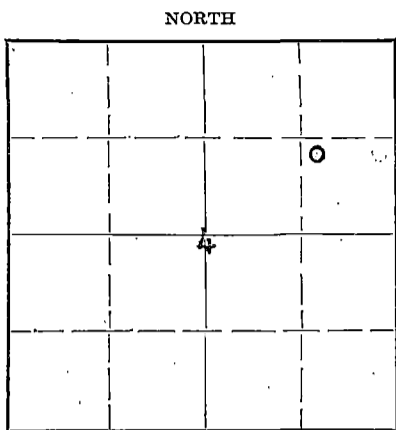

Locate well correctly on above
Section Plat

Stafford County. Sec. 4 Twp. 21 Rge. 13 (E) W (W)
Location as "NE 1/4 NW 1/4 SW 1/4" or footage from lines NW SE NE
Lease Owner The El Dorado Refining Co. Etal
Lease Name SHARP Well No. 1
Office Address Box 551, El Dorado, Kansas
Character of Well (completed as Oil, Gas or Dry Hole) Oil
Date well completed 9-29-50
Application for plugging filed 11-2-19 50
Application for plugging approved 11-4-19 50
Plugging commenced 11-22-19 50
Plugging completed 11-28-19 50
Reason for abandonment of well or producing formation Non Commerical

If a producing well is abandoned, date of last production 11-4-19 50
Was permission obtained from the Conservation Division or its agents before plugging was commenced? Yes

Name of Conservation Agent who supervised plugging of this well C. D. Stough
Producing formation arbuckle Depth to top 3558' Bottom Total Depth of Well 3574' Feet
Show depth and thickness of all water, oil and gas formations.

OIL, GAS OR WATER RECORDS

CASING RECORD

Formation	Content	From	To	Size	Put In	Pulled Out
				8-5/8"	305')))
				5 1/2"	3578' 0"	1944.60'

Describe in detail the manner in which the well was plugged, indicating where the mud fluid was placed and the method or methods used in introducing it into the hole. If cement or other plugs were used, state the character of same and depth placed, from.....feet to.....feet for each plug set.

Filled hole with rock from 3575' to 3565'
Run 5 sacks of cement at 3565' - mudded to 300' - Set bridge & run 15 sacks fo cement at 300' - mudded to 30' - run 10 sacks of cement to cap.

RECEIVED
STATE CORPORATION COMMISSION
DEC 6 - 1950
CONSERVATION DIVISION
Wichita, Kansas

(If additional description is necessary, use BACK of this sheet)
Correspondence regarding this well should be addressed to The El Dorado Refining Company
Address Box 209 - Russell, Kansas

STATE OF KANSAS, COUNTY OF RUSSELL, ss.
Levi B. Sherman (employee of owner) or (owner or operator)

being first duly sworn on oath, says: That I have knowledge of the facts, statements, and matters herein contained and the log of the above-described well as filed and that the same are true and correct. So help me God.

(Signature) Levi B. Sherman
Box 209 - Russell, Kansas
(Address)

SUBSCRIBED AND SWORN to before me this 4 day of December, 19 50
Vernel J. Brack
Notary Public.

My commission expires 10-13-52

PLUGGING
FILE SEC 4 T 21 R 13
BOOK PAGE 40 LINE 24

THE EL DORADO REFINING COMPANY

EL DORADO, KANSAS

WELL LOG - - - - - SHARP # 1

Location - NW/4 SE/4 NE/4 of Section 4-21S-13W,
Stafford County, Kansas

Owner : The El Dorado Refining Company Etal.
Contractor: Sterling Drilling Company

Commenced: 8-31-50

Completed: 9-12-50

Total Depth: 3575' (w/r)

LOGCASING RECORD

0-80'	Sand
80-115	Shale
115-145	Sand and Iron
145-150	Iron
150-290	Shale and Shells
290-305	Shale
305-750	Red Bed
750-765	Anhydrite
765-1150	Shale
1150-1550	Shale and shells
1550-1970	Shale and Lime
1970-2225	Lime
2225-2485	Lime and Shale
2485-2675	Shale and Shells
2675-2935	Lime & shale
2935-3095	Lime
3095-3265	Shale and Lime
3265-3295	Shale
3295-3515	Lime
3515-3550	Conglomerate
3550-3575	Shale

305' of 6-5/8" Casing cemented
with 225 sacks of cement.

3575' of 5 1/2" Casing cemented with
100 sacks of cement.

RECEIVED

STATE CORPORATION COMMISSION

DEC 1 - 1950

REGISTRATION DIVISION

Topeka, Kansas

FILE
BOOK PAGE 40 LINE 24
21 - R 13W

C-O-P-Y

15.185.01675.0000

THE EL DORADO REFINING COMPANY

EL DORADO, KANSAS

WELL LOG ----- SHARP # 1

Location - NW/4 SE/4 NE/4 of Section 4-218-13W,
Stafford County, Kansas

Owner : The El Dorado Refining Company Etal
Contractor: Sterling Drilling Company

Commenced: 8-31-50
Completed: 9-12-50

Total Depth: 3575' (w/r)

LOG

CASING RECORD

0- 80'	Sand
80- 115	Shale
115- 145	Sand and Iron
145- 150	Iron
150- 290	Shale and Shells
290- 305	Shale
305- 750	Red Bed
750-765	Anhydrite
765-1150	Shale
1150-1550	Shale and shells
1550-1970	Shale and Lime
1970-2225	Lime
2225-2485	Lime and Shale
2485-2675	Shale and Shells
2675-2935	Lime & shale
2935-3095	Lime
3095-3265	Shale and Lime
3265-3295	Shale
3295-3515	Lime
3515-3550	Conglomerate
3550-3575	Shale

305' of 8-5/8" Casing cemented
with 225 sacks of cement.

3575' of 5 1/2" Casing cemented with
100 sacks of cement.

PLUGGING
 FILE SEC 4 T 81 R 13W
 BOOK PAGE 40 LINE 24

RECEIVED
STATE CORPORATION COMMISSION

NOV - 4 1950

CONSERVATION
Wichita, Kan.

C-0-P-Y