


Give All Information Completely
Make Required Affidavit
Mail or Deliver Report to:
Conservation Division
State Corporation Commission
11 No. Broadway
Wichita, Kansas

WELL PLUGGING RECORD

Stafford County. Sec. 4 Twp. 21 Rge. (E) 13(W)

Location as "NE/CNW%SW%" or footage from lines SW NW NW
Lease Owner Chief Drilling Co., Inc.
Lease Name TUCKER "C" Well No. 1
Office Address Box 797 - Great Bend, Kansas
Character of Well (completed as Oil, Gas or Dry Hole) Dry Hole
Date well completed 6/30 19 62
Application for plugging filed 6/30 19 62
Application for plugging approved 6/30 19 62
Plugging commenced 6/30 19 62
Plugging completed 6/30 19 62
Reason for abandonment of well or producing formation Dry Hole

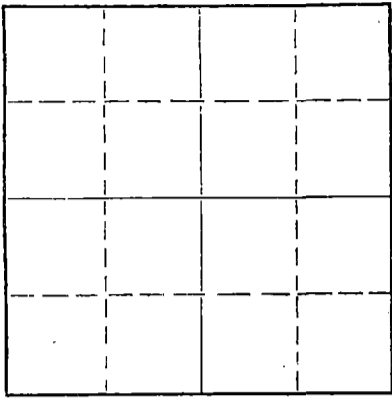

Locate well correctly on above Section Plat

If a producing well is abandoned, date of last production _____ 19____
Was permission obtained from the Conservation Division or its agents before plugging was commenced? Yes

Name of Conservation Agent who supervised plugging of this well W.L. Lackamp, Jr. - Stafford, Kansas
Producing formation _____ Depth to top _____ Bottom _____ Total Depth of Well _____ Feet
Show depth and thickness of all water, oil and gas formations.

OIL, GAS OR WATER RECORDS

CASING RECORD

FORMATION	CONTENT	FROM	TO	SIZE	PUT IN	PULLED OUT
Sand & Gravel		0	216'		216'	None

Describe in detail the manner in which the well was plugged, indicating where the mud fluid was placed and the method or methods used in introducing it into the hole. If cement or other plugs were used, state the character of same and depth placed, from _____ feet to _____ feet for each plug set.

Set wooden plug at 180' with 20 sacks cement thru drill pipe
1/3 sack hulls, set wooden plug at 35' with 10 sacks cement.

RECEIVED
STATE CORPORATION COMMISSION

7-2-62

JUL 2 1962

CONSERVATION DIVISION
Wichita, Kansas

(If additional description is necessary, use BACK of this sheet)

Name of Plugging Contractor Chief Drilling Co., Inc.
Address Box 797 - Great Bend, Kansas

STATE OF Kansas, COUNTY OF Barton, ss.

V. Richard Hoover, Pres. Chief Drlg. Co. (employee of owner) or (owner or operator) of the above-described well, being first duly sworn on oath, says: That I have knowledge of the facts, statements, and matters herein contained and the log of the above-described well as filed and that the same are true and correct. So help me God.

(Signature)

Richard Hoover
Box 797 - Great Bend, Kansas
(Address)

SUBSCRIBED AND SWORN TO before me this 30th day of June 19 62.

Carmen Reinhardt Leiker
Carmen Reinhardt Leiker, Notary Public.

My commission expires Jan. 26, 1963.



WELL LOG

Chief Drilling Co., Inc.
Box 797
Great Bend, Kansas

TUCKER "C" #1
SW NW NW Sec. 4-21S-13W
Stafford County, Kansas

Contractor: Chief Drilling Co., Inc.

Commenced: 6-21-62
Completed: 6-30-62

Casing Record: 8-5/8" @ 216.56 w/215 sacks Sunset Cement.

<u>FORMATION</u>	<u>FROM</u>	<u>TO</u>	<u>ELEVATION</u>
Sand	0	135	1895 Gr.
Hard Sand	135	155	1897 D.F.
Shale	155	216	1900 K.B.
Shale & Sand	216	767	
Anhydrite	767	787	
Shale & Red Bed	787	1575	
Shale	1575	1620	
Lime & Shale	1620	2850	
Lime	2850	3490	
Lime & Conglomerate	3490	3550	
Lime	3550	3555	
Conglomerate	3555	3625	
Total Depth	3625		

FORMATION TOPS

Anhydrite	767	+1133
Heebner	3173	-1273
Brown Lime	3292	-1392
Lansing	3305	-1405
Conglomerate	3529	-1629
T.D.	3625	

STATE OF KANSAS, COUNTY OF BARTON)SS

I hereby certify that the above is a true and correct copy of the Driller's Log of the well drilled in the SW NW NW Sec. 4-21S-13W, Stafford County, Kansas, to the best of my knowledge and belief.

CHIEF DRILLING CO., INC.

V. Richard Hoover
V. Richard Hoover, President

Subscribed and sworn to before me this 30th day of June, 1962.

Carmen Reinhardt Leiker
Carmen Reinhardt Leiker, Notary Public

My commission expires Jan. 26, 1963.

RECEIVED
STATE CORPORATION COMMISSION

JUL 2 1962

CONSERVATION DIVISION
Wichita, Kansas