

STATE OF KANSAS
STATE CORPORATION COMMISSION


WELL PLUGGING RECORD

Give All Information Completely
Make Required Affidavit
Mail or Deliver Report to:
Conservation Division
State Corporation Commission
800 Bittling Building
Wichita, Kansas

OR
FORMATION PLUGGING RECORD

Strike out upper line
when reporting plugging
of formations.

NORTH

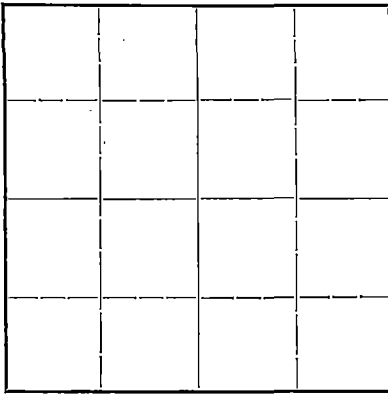

Locate well correctly on above
Section Plat

Barton County, Sec. 4 Twp. 13 Rge. 21 (E) (W)

Location as "NE 1/4 NW 1/4 SW 1/4" or footage from lines. 1650 East Line 660 North Line

Lease Owner L. J. Bodine

Lease Name Willcut #3 Well No.

Office Address Box 106 Bodine Drilling Company

Character of Well (completed as Oil, Gas or Dry Hole) Dry Hole.

Date well completed August 26, 1941

Application for plugging filed 9-21-41 19

Application for plugging approved 9-21-41 19

Plugging commenced September 21, 1941

Plugging completed 9-24-41 19

Reason for abandonment of well or producing formation Dry Hole, Water

If a producing well is abandoned, date of last production 19

Was permission obtained from the Conservation Division or its agents before plugging was commenced? Yes.

Name of Conservation Agent who supervised plugging of this well Alexander

Producing formation McC line Depth to top 3431 Bottom 3431 Total Depth of Well 3431 Feet

Show depth and thickness of all water, oil and gas formations.

OIL, GAS OR WATER RECORDS

CASING RECORD

Formation	Content	From	To	Size	Put In	Pulled Out
Kansas City Lime	Water	3421	3432	5 1/2 OD	3421	1455

Describe in detail the manner in which the well was plugged, indicating where the mud fluid was placed and the method or methods used in introducing it into the hole. If cement or other plugs were used, state the character of same and depth placed, from 3420 feet to 3384 feet for each plug set.


1967 Feet of 5 1/2 OD Casing left in well. Filled with 14 lb mud from 3395 to

Drove lead wool and shut water off from 3431 to 3420. Filled hole with 14# mud from 3420 to 3384. Set bridge and cemented with dump bailer from 3384 to 3364 Filled with 14# mud from 3364 to 313 ft. Cemented from 313 to 293' filled with mud to 30' and filled with cement to 22' filled with mud to top and cap welded on top Surface casing.

10-15-41

pd
10/10/41
H

PLUGGING
FILE 4 210 130
BOOK PAGE 8 LINE 24

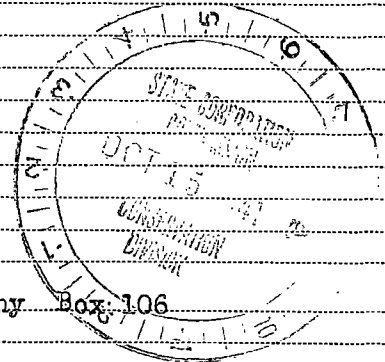

(If additional description is necessary, use BACK of this sheet)

Correspondence regarding this well should be addressed to Bodine Drilling Company Box 106
Address

STATE OF Kansas, COUNTY OF Barton, ss.
L. J. Bodine, Owner (employee of owner) or (owner or operator) of the above-described well,
being first duly sworn on oath, says: That I have knowledge of the facts, statements, and matters herein contained and the log of the above-described well as filed and that the same are true and correct. So help me God.

(Signature)

Box 106 Great Bend, Kansas
(Address)

SUBSCRIBED AND SWORN TO before me this 14 day of October, 1941

Samuel N. Yes
Notary Public.

My commission expires April 16, 1944



Bodine Drilling Company


OIL WELL DRILLING CONTRACTOR AND PRODUCER
CORK BUILDING

GREAT BEND, KANSAS

October 9, 1941

L. J. Bodine Willcut Well No. 3 in Section 4-24-13W Stafford County, Kansas

Formation	from	Depth	to
Surface Clay	0		120
Lime & Sand	120		155
Blue Shale	155		160
Shale & Shells	160		230
Sand	230		270
Shale & Shells	270		298
Red Bed & Shells	298		340
Red Bed	340		755
Anhydrite	755		775
Shale & Shells	775		800
Red Bed & Shells	800		1175
Shale & Shells	1175		1405
Lime (Sandy)	1595		1710
Sand & Lime	1710		1770
Lime & Shale	1780		1790
Sand	1890		1910
Lime & Shale	1910		1980
Sandy Lime	2020		2023
Shale & Shells	2023		2060
Shale	2755		2820
Shale & Lime	2820		2885
Lime	2980		3010
Lime & Shale	3010		3080
Lime	3080		3140
Shale & Lime	3170		3230
Shale	3230		3280
Broken Lime & Shale	3280		3320
Shale & Lime	3320		3340
Shale- Black	3340		3380
Lime & Shale	3380		3420
Shale	3420		3422
Broken Lime & Shale	3422		3425
Kans, City Lime, Cored	3425		3431 <i>water</i>

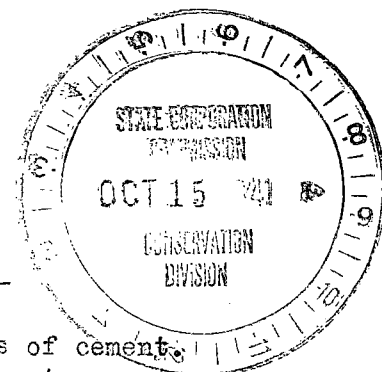

Set 313' of 8 5/8" Surface Pipe and cemented with 75 sacks of cement.
Set 3421' of 5 1/2" OD Casing 108 joints with 50 sacks of cement.

This well was plugged and abandoned

