


WELL PLUGGING RECORD

Give All Information Completely  
Make Required Affidavit  
Mail or Deliver Report to:  
Conservation Division  
State Corporation Commission  
800 Bitting Building  
Wichita, Kansas

Stafford County, Sec. 4 Twp 21S Rge. 13W (E) (W)  
Location as "NE/CNW&SW¼" or footage from lines NW NW SE  
Lease Owner Francis Oil & Gas, Inc.  
Lease Name Wilcutt Well No. "A"-4  
Office Address 905 Palace Bldg. Tulsa, Okla.  
Character of Well (completed as Oil, Gas or Dry Hole) Dry Hole  
Date well completed July 14 1955  
Application for plugging filed July 14 1955  
Application for plugging approved July 14 1955  
Plugging commenced July 14 1955  
Plugging completed July 14 1955  
Reason for abandonment of well or producing formation Dry Hole

NORTH

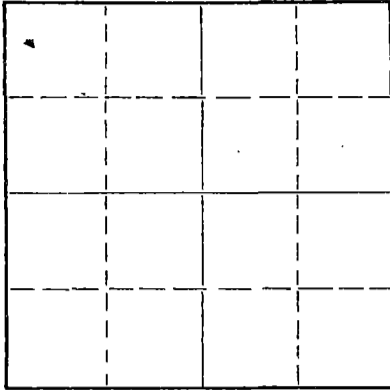

Locate well correctly on above Section Plat

If a producing well is abandoned, date of last production 19  
Was permission obtained from the Conservation Division or its agents before plugging was commenced? Yes

Name of Conservation Agent who supervised plugging of this well Warren Horner  
Producing formation \_\_\_\_\_ Depth to top \_\_\_\_\_ Bottom \_\_\_\_\_ Total Depth of Well 3610' Feet  
Show depth and thickness of all water, oil and gas formations.

OIL, GAS OR WATER RECORDS

CASING RECORD

FORMATION	CONTENT	FROM	TO	SIZE	PUT IN	PULLED OUT
				8 5/8"	140'	cemented w/150 sacks

Describe in detail the manner in which the well was plugged, indicating where the mud fluid was placed and the method or methods used in introducing it into the hole. If cement or other plugs were used, state the character of same and depth placed, from \_\_\_\_\_ feet to \_\_\_\_\_ feet for each plug set.

Plugged hole with 50 barrel mud into formation and 85 sacks cement, pumped down by Globe Cementing Company

7-22-55

LESLAWSON  
WICHITA, KANSAS  
CONSERVATION DIVISION  
WICHITA, KANSAS

(If additional description is necessary, use BACK of this sheet)

Name of Plugging Contractor Veeder Supply and Development Co.  
Address P. O. Box 201, Cherryvale, Kansas

STATE OF Kansas, COUNTY OF Montgomery, ss.  
Leo C. Veeder (employee of owner) or (owner or operator) of the above-described well, being first duly sworn on oath, says: That I have knowledge of the facts, statements, and matters herein contained and the log of the above-described well as filed and that the same are true and correct. So help me God.

(Signature) Leo C. Veeder  
Cherryvale, Kansas (Address)


SUBSCRIBED AND SWORN TO before me this 18th day of July, 1955

Les Lawson

My commission expires July 11, 1956 Notary Public.

PLUGGING  
FILED SEC 4 T 21 R 13W  
BOOK PAGE 135 LINE 84

Veeder Supply & Dev'l. Co.

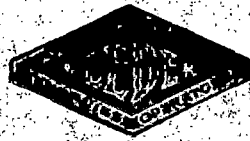

Cherryvale, Kansas

Drilled for Herman Geo. Kaiser, Francis Oil & Gas Farm Wilcutt No. 4 Depth 3610'  
 Contractor Veeder Supply & Development Co. Pipe 140' 8 5/8" csg. cemented w/150 sacks cement  
 Location NW NW SE Sec 4 Twp. 21 Range 13W  
 Commenced 6-29-1955 Completed 7-11-1955 County Stafford State Kansas

Sand and gravel	0	130	130
Sand and pyrite	130	138	8
Pyrite	138	140	2
Pyrite, iron	140	209	69
Sand and shale	209	485	276
Red bed and shale	485	752	267
Anhydrite	752	786	34
Shale and shells	786	1300	514
Lime and shale	1300	1540	240
Shale and shells	1540	1590	50
Shale and lime	1590	1810	220
Lime	1810	1830	20
Broken lime	1830	1900	70
Lime	1900	2000	100
Lime and shale	2000	2105	105
Lime	2105	2252	147
Shale and lime	2252	2330	78
Shale	2330	2527	197
Shale and lime	2527	3040	513
Lime	3040	3195	155
Shale and lime	3195	3290	95
Lime	3290	3610	320
T. D.	3610		

Dry and abandoned

AFFIDAVIT

STATE OF KANSAS )  
 Montgomery County) SS

Leo C. Veeder, of lawful age, being first duly sworn on oath, deposes and says:

THAT he is a resident of Cherryvale, Montgomery County, Kansas; that he knows and on oath hereby states that the above drilling log covering the Wilcutt "A"-4 well located in Section 4-21S-13W, Stafford County, Kansas, is true and correct. Further affiant saith not.

THE VEEDER SUPPLY AND DEVELOPMENT CO.

By Leo C. Veeder  
 Leo C. Veeder

Subscribed and sworn to before me this 18th day of July, 1955.

Les Lawson  
 Notary Public

My commission expires July 11, 1956.

RECEIVED  
 STATE CORPORATION COMMISSION  
 JUL 22 1955  
 CONSERVATION DIVISION  
 Wichita, Kansas

PLUGGING  
 FILE SEC 4 T & L R 13W  
 BOOK PAGE 135 LINE 22