


WELL PLUGGING RECORD

Give All Information Completely
Make Required Affidavit
Mail or Deliver Report to:
Conservation Division
State Corporation Commission
211 No. Broadway
Wichita, Kansas

T-21 NORTH R-12W

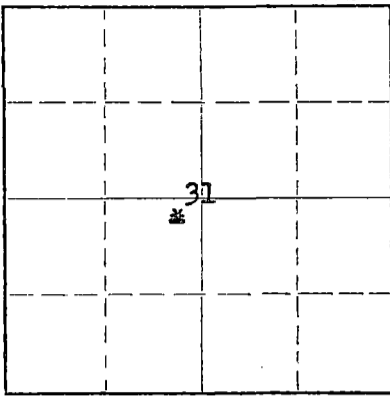

Locate well correctly on above
Section Plat

Stafford County. Sec. 31 Twp. 21 Rge. (E) 12 (W)
Location as "NE/CNW&SW&" or footage from lines NE - NW - SW
Lease Owner Frank J. Black
Lease Name Fisher Well No. 2
Office Address McPherson, Kansas
Character of Well (completed as Oil, Gas or Dry Hole) Oil Well
Date well completed 7-6 19 51
Application for plugging filed 10-23 19 57
Application for plugging approved 10-24 19 57
Plugging commenced 10-30 19 57
Plugging completed 11- 5 19 57
Reason for abandonment of well or producing formation Unprofitable

If a producing well is abandoned, date of last production Unknown 19
Was permission obtained from the Conservation Division or its agents before plugging was commenced? Yes

Name of Conservation Agent who supervised plugging of this well Donald Truan
Producing formation _____ Depth to top _____ Bottom _____ Total Depth of Well 3653 Feet
Show depth and thickness of all water, oil and gas formations.

OIL, GAS OR WATER RECORDS

CASING RECORD

FORMATION	CONTENT	FROM	TO	SIZE	PUT IN	PULLED OUT
				8 5/8	261	None
				4 1/2	3649	1640.62

Describe in detail the manner in which the well was plugged, indicating where the mud fluid was placed and the method or methods used in introducing it into the hole. If cement or other plugs were used, state the character of same and depth placed, from _____ feet to _____ feet for each plug set.

Sanded to 3640 - dumped 5 sks cement - pulled pipe -
mudded hole to 275' - set rock bridge - dumped 25 sks cement - mudded
to 40' - set rock bridge - dumped 10 sks cement.

RECEIVED
STATE CORPORATION COMMISSION

NOV 16 1957

CONSERVATION DIVISION
Wichita, Kansas

(If additional description is necessary, use BACK of this sheet)
Name of Plugging Contractor R & D Casing Pulling Company License # 236
Address Box 569 Ellinwood, Kansas

STATE OF McPherson, COUNTY OF Kansas, ss.
_____, (employee of owner) or (owner or operator) of the above-described well, being first duly sworn on oath, says: That I have knowledge of the facts, statements, and matters herein contained and the log of the above-described well as filed and that the same are true and correct. So help me God.
(Signature) _____

SUBSCRIBED AND SWORN TO before me this 15 day of Nov, 19 57

Notary Public.

My commission expires Jan 10 1961

PLUGGING
FILE SEC 31 T 21 R 12W
BOOK PAGE 56 LINE 19

COPY


WELL LOG BUREAU—KANSAS GEOLOGICAL SOCIETY
503 East Murdock, Wichita, Kansas

Company- M. DIZDAR, PETROLEUM INVESTMENT COMPANY
Farm- Fischer No. 2

SEC. 31 T. 21 R. 12W
NE NW SW

Total Depth. 3053
Comm. 6-24-51 Comp. 7-6-51
Shot or Treated.
Contractor. Dizdar & Nye Drilling Co.
Issued. 7-11-53

County Stafford
KANSAS

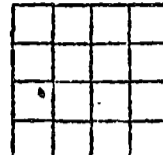

CASING:

8 5/8" 241'
4 1/2" 3649'

Elevation. 1874

Production. Pmp 300 bbls

Figures indicate Bottom of Formations.

sand 310
red bed 685
shale, shells 700
shale 805
anhydrite 860
shale 1090
shale, strks anhyd. 1360
shale, shells 1520
lime, sand 1560
lime, shale 2995
shale, sandy lime 3120
lime, shale 3445
lime 3480
lime, shale 3595
shale simpson 3614
lime, shale 3641
lime 3646
shale, lime 3648
arbuckle 3653
Total Depth

Tops:
Anhydrite (Scout) 815
Heebner 3166
Kansas City 3299
Viola 3563
Simpson 3592
Arbuckle 3648
1874
1774

RECEIVED
STATE CORPORATION COMMISSION
OCT 24 1953
CONSERVATION DIVISION
WICHITA, KANSAS

PLUGGING
FILE SEC. 31 T. 21 R. 12W
BOOK PAGE 56 LINE 19