

STATE OF KANSAS
CORPORATION COMMISSION

Give All Information Completely
Make Required Affidavit
Mail or Deliver Report to:
Conservation Division
State Corporation Commission
800 Bittling Building
Wichita, Kansas

WELL PLUGGING RECORD

OR

FORMATION PLUGGING RECORD

Strike out upper line
when reporting plugging
of formations.

Stafford

County, Sec. 31 Twp. 21 Rge. 12 (W)

Location as "NE $\frac{1}{4}$ NW $\frac{1}{4}$ SW $\frac{1}{4}$ " or footage from lines SW $\frac{1}{4}$ NW $\frac{1}{4}$ SW $\frac{1}{4}$
Lease Owner The Saco Oil Co. et al
Lease Name Fischer Well No. 1
Office Address El Dorado, Kansas
Character of Well (completed as Oil, Gas or Dry Hole) Oil
Date, well completed Apr 11 25, 1938 19
Application for plugging filed December 1941 19
Application for plugging approved ditto 19
Plugging Commenced December 22nd, 1941 19
Plugging Completed January 20th, 1942 19
Reason for abandonment of well or producing formation
Decline in production
If a producing well is abandoned, date of last production November 19 41
Was permission obtained from the Conservation Division or its agents before plugging was commenced? yes

NORTH

Locate well correctly on above
Section Plat

Name of Conservation Agent who supervised plugging of this well
Producing formation Arbuckle Depth to top 3638 Bottom 3648 Total Depth of Well 3648 Feet
Show depth and thickness of all water, oil and gas formations.


OIL, GAS OR WATER RECORDS

CASING RECORD

Formation	Content	From	To	Size	Put In	Pulled Out

Describe in detail the manner in which the well was plugged, indicating where the mud fluid was placed and the method or methods used in introducing it into the hole. If cement or other plugs were used, state the character of same and depth placed, from.....feet to.....feet for each plug set.

5 Sax Cement 3648' to 3628'
Mud 3628' to 258'
10 Sax Cement 258' to 238'
Mud 238' to 28'
10 Sax Cement to 8'
Mud to base of cellar.

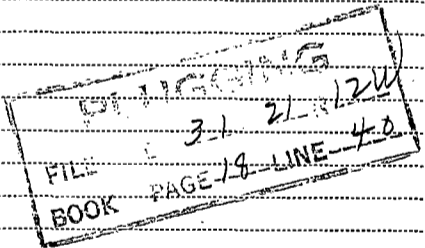

(If additional description is necessary, use BACK of this sheet)

Correspondence regarding this well should be addressed to Saco Oil Company
Address Eldorado, Kansas.

STATE OF Kansas, COUNTY OF Sedgwick, ss.

..... (employee of owner) or (owner or operator) of the above-described well,
being first duly sworn on oath, says: That I have knowledge of the facts, statements, and matters herein contained and the log of the above-described well as filed and that the same are true and correct. So help me God.

(Signature) C. L. STEINBERG & CO.
809 Ellis-Singleton Bldg
Wichita, Kansas.
STATE CORPORATION COMMISSION
(Address) 1-23-42

SUBSCRIBED AND SWORN to before me this 22nd day of January

Clytell Smalley
Notary Public.

My commission expires Dec. 6th, 1945.

SACO OIL COMPANY

15.185.10111.0000

WELL LOG

Loc: 530' S & W of NW Cor. of 1/4 Sec.

Operator The Saco Oil Company

Lease #10001 Well No. _____

Comm 3-17-33 Comp 4-25-33

Loc _____ Sec 21 Twp 21 Rge 12W

Shot _____ Qts. From _____ ft. To _____ ft.

County Stafford State Kansas

Acidized _____ Gal.

Contractor Triangle Ind. Co. Casing Record

Prod. Formation Siliceous

Initial Prod. _____

Elevation 1874

Size	Ft.	Pulled	Remarks
10 3/4"	250		How
7"	3041		

FIGURES INDICATE BOTTOM OF FORMATION


sand and clay	0	40
sand and shells	40	107
sand	197	235
shale	235	260
shale and shells	260	460
red bed-shale	460	500
anhydrite	690	730
red bed-red rock	730	855
shale and red rock	855	980
shale and shells	980	1020
shale-chert shells	1020	1165
shale & shells	1165	1195
salt-shale	1195	1350
anhydrite	1350	1355
shale and lime	1355	1725
lime	1725	1765
lime and shale	1765	1800
lime	1800	1870
lime and shale	1870	1920
broken lime	1920	1950
lime	1950	1955
shale and lime	1955	2020
lime and shale	2020	2765
shale and lime	2765	2790
lime and shale	2790	2850
shale sandy	2850	2860
lime and shale	2860	2910
shale and chert	2910	3020
lime and shale	3020	3075
lime	3075	3085
sandy lime and chert	3085	3085
lime	3085	3045
lime and shale	3045	3090
lime	3090	3100
lime and chert	3100	3125
lime	3125	3110
lime and shale	3110	3150
lime and chert	3150	3135
lime and shale	3135	3150
lime	3150	3160
lime and shale	3160	3200
lime	3200	3225
lime and shale	3225	3235
shale and red rock	3235	3285
shale	3285	3295
shale and lime	3295	3310
lime K.C.	3310	3400
Cored from 3401-03 and from 3402-15)		
lime	3400	3440
lime cored from 3440-45)		
lime	3440	3535
lime and shale	3535	3554
chert	3554	3595
shale-red-green	3595	3595
shale-green	3595	3610
shale green-red	3610	3625
shale	3625	3637
sandy lime	3637	3638
shale	3638	3641
lime-siliceous	3641	3643
(Cored from 3641-43)		

Upon drilling cement plug w/ cable tools, hole filled up 2500' in 43 min. with oil.

Top Kansas City Lime 3310'
 Viola Chert 3084'
 Simpson 3085'
 Siliceous 3641'

Two cores were taken in Kansas City lime and one core taken in Siliceous lime.

FILED 3) 2LR-12W
 BOOK PAGE 18 LINE 40

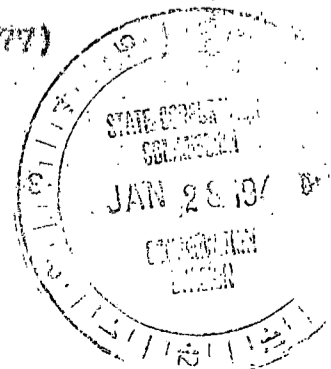

show of oil 3470-77)

Total depth 3643'