


WELL PLUGGING RECORD

Give All Information Completely
Make Required Affidavit
Mail or Deliver Report to:
Conservation Division
State Corporation Commission
800 Bittling Building
Wichita, Kansas

NORTH

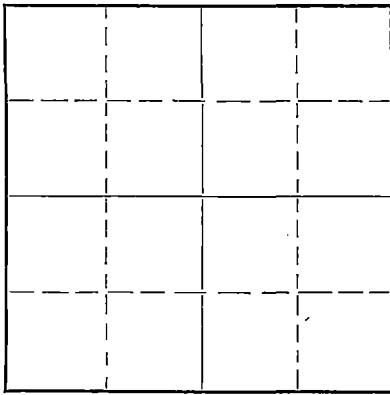

Locate well correctly on above
Section Plat

Stafford County. Sec. 31 Twp. 21 Rge. 12 (E) (W)
Location as "NE/CNW $\frac{1}{4}$ SW $\frac{1}{4}$ " or footage from lines NW NE SW
Lease Owner Dizdar Petroleum Investment Company
Lease Name Fischer Well No. 3
Office Address 1201 Main St., Great Bend, Kansas
Character of Well (completed as Oil, Gas or Dry Hole) Dry Hole
Date well completed July 20 19 51
Application for plugging filed July 20 19 51
Application for plugging approved July 20 19 51
Plugging commenced July 20 19 51
Plugging completed July 20 19 51
Reason for abandonment of well or producing formation Dry Hole

If a producing well is abandoned, date of last production 19
Was permission obtained from the Conservation Division or its agents before plugging was commenced? Yes

Name of Conservation Agent who supervised plugging of this well Charlie Stow
Producing formation Depth to top Bottom Total Depth of Well 3679 Feet
Show depth and thickness of all water, oil and gas formations.

OIL, GAS OR WATER RECORDS

CASING RECORD

Formation	Content	From	To	Size	Put In	Pulled Out
				8 5/8"	262'	None

Describe in detail the manner in which the well was plugged, indicating where the mud fluid was placed and the method or methods used in introducing it into the hole. If cement or other plugs were used, state the character of same and depth placed, from feet to feet for each plug set.

Pushed cementers plug to 260' and cemented with 15 sacks of portland cement, pushed 2nd plug to 10' and cemented to bottom of cellar with 10 sacks of portland cement.

8-10-51

RECEIVED
STATE CORPORATION COMMISSION
AUG 10 1951

(If additional description is necessary, use BACK of this sheet)

Correspondence regarding this well should be addressed to Dizdar & Nye Drilling Company
Address Box 30, Hays, Kansas

STATE OF Kansas, COUNTY OF Ellis, ss.

Glenn R. Nye (employee of owner) or (owner or operator) of the above-described well, being first duly sworn on oath, says: That I have knowledge of the facts, statements, and matters herein contained and the log of the above-described well as filed and that the same are true and correct. So help me God.

(Signature) Glenn R. Nye
Box 30, Hays, Kansas (Address)

SUBSCRIBED AND SWORN TO before me this 8th day of August, 19 51

John L. Biess Notary Public.

My commission expires May 9, 1953

PLUGGING
REC SEC 31 21 R 12
BOOK PAGE 27 LINE 2

