

WELL PLUGGING RECORD

Give All Information Completely
Make Required Affidavit
Mail or Deliver Report to:
Conservation Division
State Corporation Commission
800 Bitting Building
Wichita, Kansas

Stafford County. Sec. 35 Twp. 21 Rge. 13 (W)

Location as "NE/CNW/SW" or footage from lines SE NW SW

Lease Owner Sohio Petroleum Company

Lease Name Drach Well No. 3

Office Address Russell, Kansas

Character of Well (completed as Oil, Gas or Dry Hole) Dry Hole

Date well completed 8-13 19 53

Application for plugging filed 10-18 19 54

Application for plugging approved 10-20 19 54

Plugging commenced 10-28 19 54

Plugging completed 10-30 19 54

Reason for abandonment of well or producing formation


If a producing well is abandoned, date of last production 19

Was permission obtained from the Conservation Division or its agents before plugging was commenced? Yes

Name of Conservation Agent who supervised plugging of this well M. A. Rives

Producing formation Depth to top Bottom Total Depth of Well 3768 Feet

Show depth and thickness of all water, oil and gas formations.

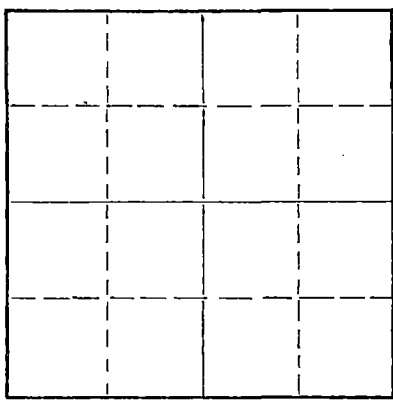

Locate well correctly on above Section Plat

OIL, GAS OR WATER RECORDS

CASING RECORD

FORMATION	CONTENT	FROM	TO	SIZE	PUT IN	PULLED OUT
Arbuckle		3695'	3768'	5 1/2"	3767'	1970'

Describe in detail the manner in which the well was plugged, indicating where the mud fluid was placed and the method or methods used in introducing it into the hole. If cement or other plugs were used, state the character of same and depth placed, from feet to feet for each plug set.

A Lane-Wells plug was set at 3762' and casing was perforated from 3700' to 3708'. Filled hole with sand from 3762' to 3690' and ran 5 sacks of cement. Ran 17 sacks of mud. Bailed hole to 240', set a 10' rock bridge and ran 20 sacks of cement. Mudded hole to 35', set a rock bridge and ran 10 sacks of cement on top. Plugging completed.

(If additional description is necessary, use BACK of this sheet)

Name of Plugging Contractor West Supply Company
Address Chase, Kansas

STATE OF Kansas, COUNTY OF Russell, ss.
J. H. Bond (employee of owner) or (owner or operator) of the above-described


well, being first duly sworn on oath, says: That I have knowledge of the facts, statements, and matters herein contained and the log of the above-described well as filed and that the same are true and correct. So help me God.

(Signature) J. H. Bond

SUBSCRIBED AND SWORN to before me this 24th day of November, 19 54

Russell Miller
Notary Public.

My commission expires My Commission Expires July 2, 1957

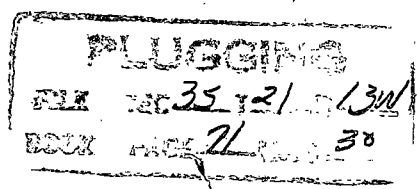

11-26-54

COPY

COPY

15.185.11793.0000

DRILLER'S LOG DRACH NO. 3

Sohio Petroleum Co., Operator

Section 35, Twp. 21S, Rge. 13W

Garvey Drilling Company, Contract

Location: SE NW SW

Drilling Commenced: July 24, 1953

County: Stafford County, Kansas

Drilling Completed: August 5, 1953

R.T.D.: 3768'

Casing Record: 8-5/8" @ 243' w/200 sax
5-1/2" @ 3767' w/100 sax

Elevation: 1882'

Figures below indicate bottom of formation:

40 Sand
150 Shale, Shells & Sand
* 235 Shells & Sand * 243 Shale
260 Shale & Shells
716 Red Bed
745 Anhydrite
1570 Shale & Shells
2130 Lime & Shale
2265 Lime
2300 Lime
3220 Lime & Shale
3481 Lime
3540 Lime & Shale
3606 Lime
3722 Lime & Shale
3768 Lime

Tops:

Topeka: 2985
Br. Line: 3328
Lansing: 3346
Arbuckle: 3697

3768 R.T.D.

I hereby certify that this is a true and correct log of the above mentioned well.

GARVEY DRILLING CO.

By /S/ W. W. Fisher

STATE OF KANSAS)
) SS:
COUNTY OF SEDGWICK)

Subscribed to and sworn to before me, a Notary Public, in said County and State, this 12th day of August, 1953.

/S/ Charlotte Weidman
Notary Public

My commission expires: October 13, 1954

PLUGGING
WELL SEC 35 21 R 13W
BOOK PAGE 21 LINE 30