

STATE OF KANSAS
STATE CORPORATION COMMISSION


Give All Information Completely
Make Required Affidavit
Mail or Deliver Report to:
Conservation Division
State Corporation Commission
212 No. Market
Wichita, Kansas

WELL PLUGGING RECORD

STAFFORD County. Sec. 35 Twp. 21S Rge. (E) 13 (W)

Location as "NE/CNW/SW" or footage from lines NE SE SW
Lease Owner A. L. ABERCROMBIE, INC.
Lease Name DRACH Well No. 4
Office Address 801 UNION CENTER - WICHITA, KANSAS
Character of Well (completed as Oil, Gas or Dry Hole) OIL
Date well completed JAN. 19 19 54
Application for plugging filed 19
Application for plugging approved JULY 29 19 69
Plugging commenced AUGUST 18 19 69
Plugging completed AUGUST 29 19 69
Reason for abandonment of well or producing formation DEPLETED

NORTH

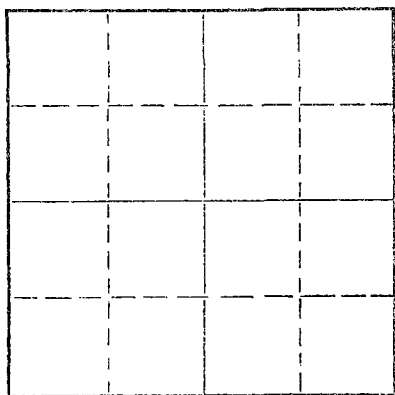

Locates well correctly on above Section Plat

If a producing well is abandoned, date of last production 19
Was permission obtained from the Conservation Division or its agents before plugging was commenced? YES

Name of Conservation Agent who supervised plugging of this well R. J. WARREN
Producing formation Depth to top Bottom Total Depth of Well 3840' Feet
Show depth and thickness of all water, oil and gas formations.

OIL, GAS OR WATER RECORDS

CASING RECORD

FORMATION	CONTENT	FROM	TO	SIZE	PUT IN	PULLED OUT
				10 3/4"	267'	None
				7"	3839'	1766.79'

Describe in detail the manner in which the well was plugged, indicating where the mud fluid was placed and the method or methods used in introducing it into the hole. If cement or other plugs were used, state the character of same and depth placed, from feet to feet for each plug set.

3840' - 3630' - PLUG
3630' - 3485' - SAND
3485' - 3443' - SIX SACKS CEMENT
3443' - BASE - PUMPED 20 SACKS MUD AND 100 SACKS CEMENT.

RECEIVED
STATE CORPORATION COMMISSION
SEP 8 1969
CONSERVATION DIVISION
Wichita, Kansas

(If additional description is necessary, use BACK of this sheet)
Name of Plugging Contractor SANTA-FE PIPE & SUPPLY, INC+
Address BOX 562 - GREAT BEND, KANSAS

STATE OF KANSAS, COUNTY OF BARTON, ss.
T. L. Nutt (employee of owner) or (owner or operator) of the above-described well, being first duly sworn on oath, says: That I have knowledge of the facts, statements, and matters herein contained and the log of the above-described well as filed and that the same are true and correct. So help me God.

(Signature) *T. L. Nutt*
Box. 562 - Great Bend, Kansas
(Address)

SUBSCRIBED AND SWORN TO before me this 5th day of September, 19 69

Mary M. Guesnier
Mary M. Guesnier Notary Public.

My commission expires July 31, 1970

CONTRACTOR'S WELL LOG

COMPANY: Musgrove Petroleum Corporation
 CONTRACTOR: Musgrove Petroleum Corporation
 FARM: Drach #4
 LOCATION: NE SE SW, Section 35-21-13,
 Stafford County, Kansas.
 COMMENCED: October 16, 1953
 COMPLETED: October 30, 1953

0	40	Surface clay
40	231	Sand
231	264	Hard gray shale
264	717	Red bed
717	740	Anhydrite
740	1440	Shale
1440	1662	Shale & lime shells
1662	3589	Shale & lime
3589	3624	Lime
3624	3666	Shale
3666	3840	Arbuckle
	3840	Rotary Total Depth

RECEIVED
 STATE CORPORATION COMMISSION
 JUL 29 1969
 CONSERVATION DIVISION
 Wichita, Kansas

Set 10-3/4" surface casing at 264' with 235 sacks cement.

Set 7" casing at 3839' with 150 sacks cement.

STATE OF KANSAS)
) SE
 COUNTY OF SEDGWICK)

I, GORDON L. KOELLING, do hereby certify that the above and foregoing is a true and correct copy of the log of the Drach #4, NE SE SW Section 35-21-13, Stafford County, Kansas, as reflected by the files of the Musgrove Petroleum Corporation.

MUSGROVE PETROLEUM CORPORATION

Gordon L. Koelling
 Secretary-Treasurer

Subscribed and sworn to before me, a Notary Public, in and for Sedgwick County, Kansas, this 3rd day of November, 1953.

Thomas S. Stancavage
 Notary Public

My commission expires September 24, 1956.