

WELL PLUGGING RECORD

Give All Information Completely  
Make Required Affidavit  
Mail or Deliver Report to:  
Conservation Division  
State Corporation Commission  
800 Bittling Building  
Wichita, Kansas

Stafford County, Sec. 35 Twp. 21 Rge. 13 (E) (W)

Location as "NE/CNW $\frac{1}{4}$ /SW $\frac{1}{4}$ " or footage from lines NW SW SW

Lease Owner Sohio Petroleum Company

Lease Name Drach Well No. 2

Office Address Russell, Kansas

Character of Well (completed as Oil, Gas or Dry Hole) Dry

Date well completed 1-22 1950

Application for plugging filed 1-23 1950

Application for plugging approved --- 1950


Plugging commenced 1-22 1950

Plugging completed 1-22 1950

Reason for abandonment of well or producing formation Dry

If a producing well is abandoned, date of last production 19

Was permission obtained from the Conservation Division or its agents before plugging was commenced? Yes

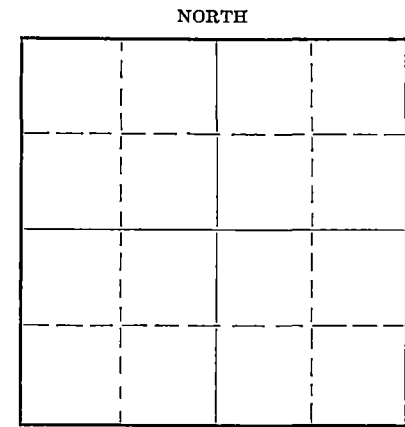

Locate well correctly on above Section Plat

Name of Conservation Agent who supervised plugging of this well C. D. Stough

Producing formation --- Depth to top --- Bottom --- Total Depth of Well 3723 Feet

Show depth and thickness of all water, oil and gas formations.

OIL, GAS OR WATER RECORDS

CASING RECORD

Formation	Content	From	To	Size	Put In	Pulled Out
Red Bed				8 5/8	315'	

Describe in detail the manner in which the well was plugged, indicating where the mud fluid was placed and the method or methods used in introducing it into the hole. If cement or other plugs were used, state the character of same and depth placed, from 0 feet to 3723 feet for each plug set.

- 3723' to 300' Heavy Mud
- 300' to 250' 15 sacks cement
- 250' to 30' Heavy Mud
- 30' to 6' 10 sacks cement (Bottom of Cellar)

1-24-50

JAN 24 1950

STA

(If additional description is necessary, use BACK of this sheet)

Correspondence regarding this well should be addressed to Sohio Petroleum Company

Address Box 671  
Russell, Kansas

STATE OF Kansas, COUNTY OF Russell, ss.

J. H. Bond (employee of owner) or (owner or operator) of the above-described well, being first duly sworn on oath, says: That I have knowledge of the facts, statements, and matters herein contained and the log of the above-described well as filed and that the same are true and correct. So help me God.


(Signature) J. H. Bond

(Address)

SUBSCRIBED AND SWORN to before me this 23 day of January, 19 50

Russell Dr Miller  
Notary Public.

My commission expires Commission Expires July 2, 1953

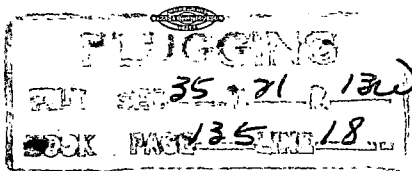

**CONTRACTOR'S VERIFIED LOG**

Operator Sohio Petroleum Company Farm Name Drach Well No. Drach #2  
 Location: NW SW SW, Section 35-T21S, R13W, Stafford County, Kansas  
 Pool Name \_\_\_\_\_ County Stafford State Kansas  
 Commencement Date January 8, 1950 Completion Date January 22, 1950

LOG OF WELL

Depth		Formation	Deviation from Vertical (Degrees)	Remarks
From	To			
0	190	Sand		
190	220	Clay & Sand		
220	245	Clay & Sand		
245	270	Clay		
270	305	Red Bed		
305	314	Shells & Red Bed		
314	317	Sand		
317	707	Red Bed		
707	721	Top Chalk & False Anhydrite		
721	725	Top Anhy		
725	741	Anhydrite		
741	1075	Red Bed & Shale		
1075	1150	Red Bed & Shale		
1150	1220	Shale & Shells		
1220	1250	Shale & Sand		
1250	1385	Shale & Shells		
1385	1430	Shale & Shells		
1430	1500	Salt		
1500	1525	Shells & Shale		
1525	1559	Salt & Shale		
1559	1570	Streaks Lime & Shale		
1570	1690	Anhydrite Shells & Shale		
1690	1710	Shale & Shells		
1710	1790	Shale & Lime		
1790	1823	Shale & Shells		
1823	1870	Shale & Lime		
1870	1975	Shale & Lime		
1975	1995	Lime		
1995	2080	Lime		
2080	2160	Lime		
2160	2180	Lime		
2180	2250	Lime & Shale		
2250	2405	Shale		
2405	2560	Lime & Shale		
2560	2690	Shale & Lime		
2690	2775	Shale & Lime		
2775	2790	Shale & Lime		
2790	2845	Lime		
2845	2950	Lime & Shale		
2950	3040	Shale & Lime		
3040	3120	Lime & Shale		
3120	3182	Lime		
3182	3235	Lime Streaks Shale		
3235	3315	Lime		
3315	3365	Lime		
3365	3405	Lime		
3405	3430	Lime		
3430	3485	Lime		
3485	3520	Lime		
3520	3522	Lime		
3522	3555	Lime		
3555	3581	Lime		
3581	3609	Lime		
3609	3651	Lime - Cherty		
3651	3680	Simpson Shale		
3680	3710	Lime & S. Shale		
3710	3711	Arbuckle		

RECORDED  
 FEB 21 1950  
 STATE COMMISSION  
 KANSAS

**PLUGGING**  
 FILE SEC 35 T21 R13W  
 BOOK PAGE 125 LINE 13

Depth		Formation	Deviation from Vertical (Degrees)	Remarks
From	To			
3711	3723	Arbuckle Lime Total Rotary Depth		
Total Rotary Depth			Total Depth	

Total Rotary Depth

Total Depth

3723

Was well to be deepened by another Contractor? \_\_\_\_\_

CASING LEFT IN HOLE AFTER COMPLETION OR ABANDONMENT

Size	Wt.	Grade	Range	Thread	Footage					
					Delivered	Run	Set At	Unused	Pulled	Left In Hole

The foregoing Well Log and other data are correct.

Deviation from vertical Data is correct as shown.

Signed: \_\_\_\_\_  
Company Superintendent  
(This space for Company use)

Duke + Wood Drilling Co., Inc  
Contractor

by *Lynn O. Duke*