

STATE OF KANSAS  
STATE CORPORATION COMMISSION  
CONSERVATION DIVISION  
P. O. BOX 17027  
WICHITA, KANSAS 67217

FORM CP-4

WELL PLUGGING RECORD

Stafford County. Sec. 35 Twp. 21 Rge. 13 (E) (W) X

Location as "NE/CNW&SW" or footage from lines E/2-NW-NW

Lease Owner Woodman-Iannitti Drilling Co.

Lease Name GATES Well No. 1

Office Address P. O. Box 308, Great Bend, Kansas 67530

Character of Well (completed as Oil, Gas or Dry Hole)

Date well completed 19

Application for plugging filed December 2, 1975

Application for plugging approved 19


Plugging commenced December 8, 1975

Plugging completed December 31, 1975

Reason for abandonment of well or producing formation Depleted

If a producing well is abandoned, date of last production 19

Was permission obtained from the Conservation Division or its agents before plugging was commenced? Yes

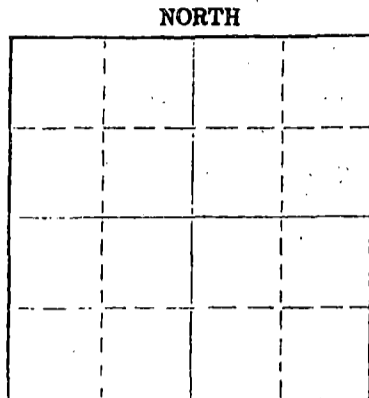

Locate well correctly on above Section Plat

Name of Conservation Agent who supervised plugging of this well G. R. Biberstein

Producing formation Depth to top Bottom Total Depth of Well 3697 Feet

Show depth and thickness of all water, oil and gas formations.

OIL, GAS OR WATER RECORDS

CASING RECORD

FORMATION	CONTENT	FROM	TO	SIZE	PUT IN	PULLED OUT
				8 5/8	261	-0-
				5 1/2	3680	2905.87'

Describe in detail the manner in which the well was plugged, indicating where the mud fluid was placed and the method or methods used in introducing it into the hole. If cement or other plugs were used, state the character of same and depth placed, from feet to feet for each plug set.

Plugged bottom back to 3650' with sand and 5 sacks cement.  
Shot casing at 3177, 3113'. Spotted oil. Shot casing at 2902'.  
Spotted oil and pumped plug to 2850'. Pulled a total of 92 joints  
of 5 1/2" casing. Plugged well with 2 sacks hulls, 10 sacks gel,  
100 sacks 50/50 Pozmix.

RECEIVED  
STATE CORPORATION COMMISSION

(If additional description is necessary, use BACK of this sheet)

Name of Plugging Contractor Rockhold Engineering, Inc. JAN 8 1976

Address P. O. Box 698, Great Bend, Kansas 67530

CONSERVATION DIVISION  
Wichita, Kansas

STATE OF Kansas COUNTY OF Barton ss. James W. Rockhold

(employee of owner) or (owner or operator) of the above-described well, being first duly sworn on oath, says: That I have knowledge of the facts, statements, and matters herein contained and the log of the above-described well as filed and that the same are true and correct. So help me God.


(Signature) James W. Rockhold

Box 698, Gt. Bend, Ks. 67530

(Address)

day of January, 1976

Cathy Peacock  
Cathy Peacock Notary Public.

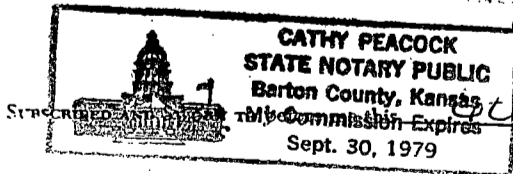

My commission expires September 30, 1979

15.185.20587.0000

K. T. WOODMAN  
RES. PHONE 733-0418  
OFF. PHONE 265-7650  
WICHITA, KANSAS

D. J. IANNITTI  
PHONE 792-2921  
GREAT BEND, KANSAS

**WOODMAN & IANNITTI DRILLING COMPANY**  
*Rotary Drilling Contractors*

1008 UNION NATIONAL BUILDING  
WICHITA, KANSAS 67202

June 26, 1975

Company;	Woodman & Iannitti Drilling Co. & Ralph Stalcup
Farm;	#1 Gates
Location;	C E/2 NW NW
Section;	35-21-13W
County;	Stafford
Contractor;	Woodman & Iannitti Drilling Co.
Comm;	June 11, 1975
Compl;	June 19, 1975
Total Depth;	3697
Casing;	8 5/8 @ 261 w/210 sx. 5 1/2" @ 3680 w/100 sx.

**Figures Indicate Bottom Of Formations:**

261	Sand & Shale
480	Shale & Red Bed
717	Red Bed
742	Anhy
1325	Shale
1735	Lime
2305	Lime
2455	Lime
2780	Lime & Shale
2915	Lime
3200	Lime & Shale
3480	Lime
3665	Lime
3686	Lime
3697	Arbuckle

I certify the above to be a true and correct copy of the driller's log to the best of my knowledge and belief.

Woodman & Iannitti Drilling Co.

*K. T. Woodman*  
K. T. Woodman

RECEIVED  
STATE CORPORATION COMMISSION

APR 14 1976

CONSERVATION DIVISION  
Wichita, Kansas