

STATE OF KANSAS
STATE CORPORATION COMMISSION
200 Colorado Derby Bldg.
Wichita, Kansas 67202

Form CP-4
Rev. 12-15-80

WELL PLUGGING RECORD

Give All Information Completely
Make Required Affidavit

COUNTY Stafford SEC. 35 TWP. 21 RGE. 13w E/W
Location as in quarters or footage from lines:
NW SW NW

Locate Well
correctly on above
Section Platt.

Lease Owner Petroleum Energy, Inc.
Lease Name Eaves #1 Well No. _____
Office Address 415 First Nat'l Bank Bldg. 105 N. Main, Wichita, Ks
Character of Well (Completed as Oil, Gas or Dry Hole): 67202
Date Well Completed _____
Application for plugging filed _____
Plugging commenced 5/24/83
Plugging completed 5/27/83
Reason for abandonment of well or producing formation _____

Depleted
Was permission obtained from the Conservation Division or it's
Agent's before plugging was commenced? Yes

Name of Conservation Agent who supervised plugging of this well Bud Metz
Producing formation _____ Depth to top _____ bottom T.D. 3696'
Show depth and thickness of all water, oil and gas formations.

OIL, GAS OR WATER RECORDS Casing Record

Formation	Content	From	To	Size	Put in	Pulled Out
				8 5/8	315'	none
				4 1/2"	3695'	2459'

Describe in detail the manner in which the well was plugged, indicating where the mud
fluid was placed and the method or methods used in introducing it into the hold. If cement
or other plugs were used, state the character of same and depth placed, from _____ feet
to _____ feet for each plug set.

Pumped bottom with 40 bbls, salt water, & 40 sacks 50/50 poz with 1 sack hulls.
Pumped plug to 3455'. Shot casing at 2998', 2792', 2597', & 2488'. Pulled total
of 65 joints. Plugged well with 5 hulls, 15 gel, 50 cement, 10 gel, released plug, 80
sacks 60/40 poz 2% gel 3% c.c.

Plugging complete.

(If additional description is necessary, use BACK of this sheet)
Name of Plugging Contractor Kelso Casing Pulling

STATE OF Kansas COUNTY OF Rice, ss.
R. Darrell Kelso (employee of owner) or (owner or operator) of the
above-described well, being first duly sworn on oath, says: That I have knowledge of the
facts, statements, and matters herein contained and the log of the above-described well as
filed and that the same are true and correct. So help me God.

(Signature) R. Darrell Kelso
Box 347, Chase, Ks. 67524
(Address)

SUBSCRIBED AND SWORN TO before me this 31st day of May, 19 83

My Commission expires:



Irene Hoover
Notary Public.

RECEIVED
STATE CORPORATION COMMISSION

JUN 02 1983

DRILLERS LOG

OPERATOR: Petroleum Energy, Inc. 710 One Twenty Bldg. Wichita, Ks. 67202
 CONTRACTOR: White & Ellis Drilling, Inc., Box 448, El Dorado, Kansas 67042

Lease Name Eaves Well No. #1
 Sec. 35 T. 21 R. 13W Spot NW SW NW
 County Stafford State Kansas Elevation _____

Casing Record:

Surface: 8 5/8 @ 315' with 275 Sxs. 2%gel
3%cc
 Production: ~~3695~~ @ ~~312~~ with 165 Sxs.

Type Well: Oil 3695 Total Depth 412 3696'

Drilling Commenced: 8-24-81 Drilling Completed 9-4-81

Formation	From	To	Tops
Cellar	0	7	Arbuckle 3683
Shale	7	1790	
Shale, Lime	1790	2091	
Lime, Shale	2091	2608	
Shale, Lime	2608	3084	
Lime	3084	3696	

COMPLETION RECORD

Liner Record: Size _____ From _____ To _____

Cementing Record: _____ Sacks _____

Perforating Record:

Formation	Perforated Interval	Number Shots


Initial Production: _____

Electric Log _____ Type and Depths Covered _____



EAVES

WELL SCHEMATIC / INFORMATION

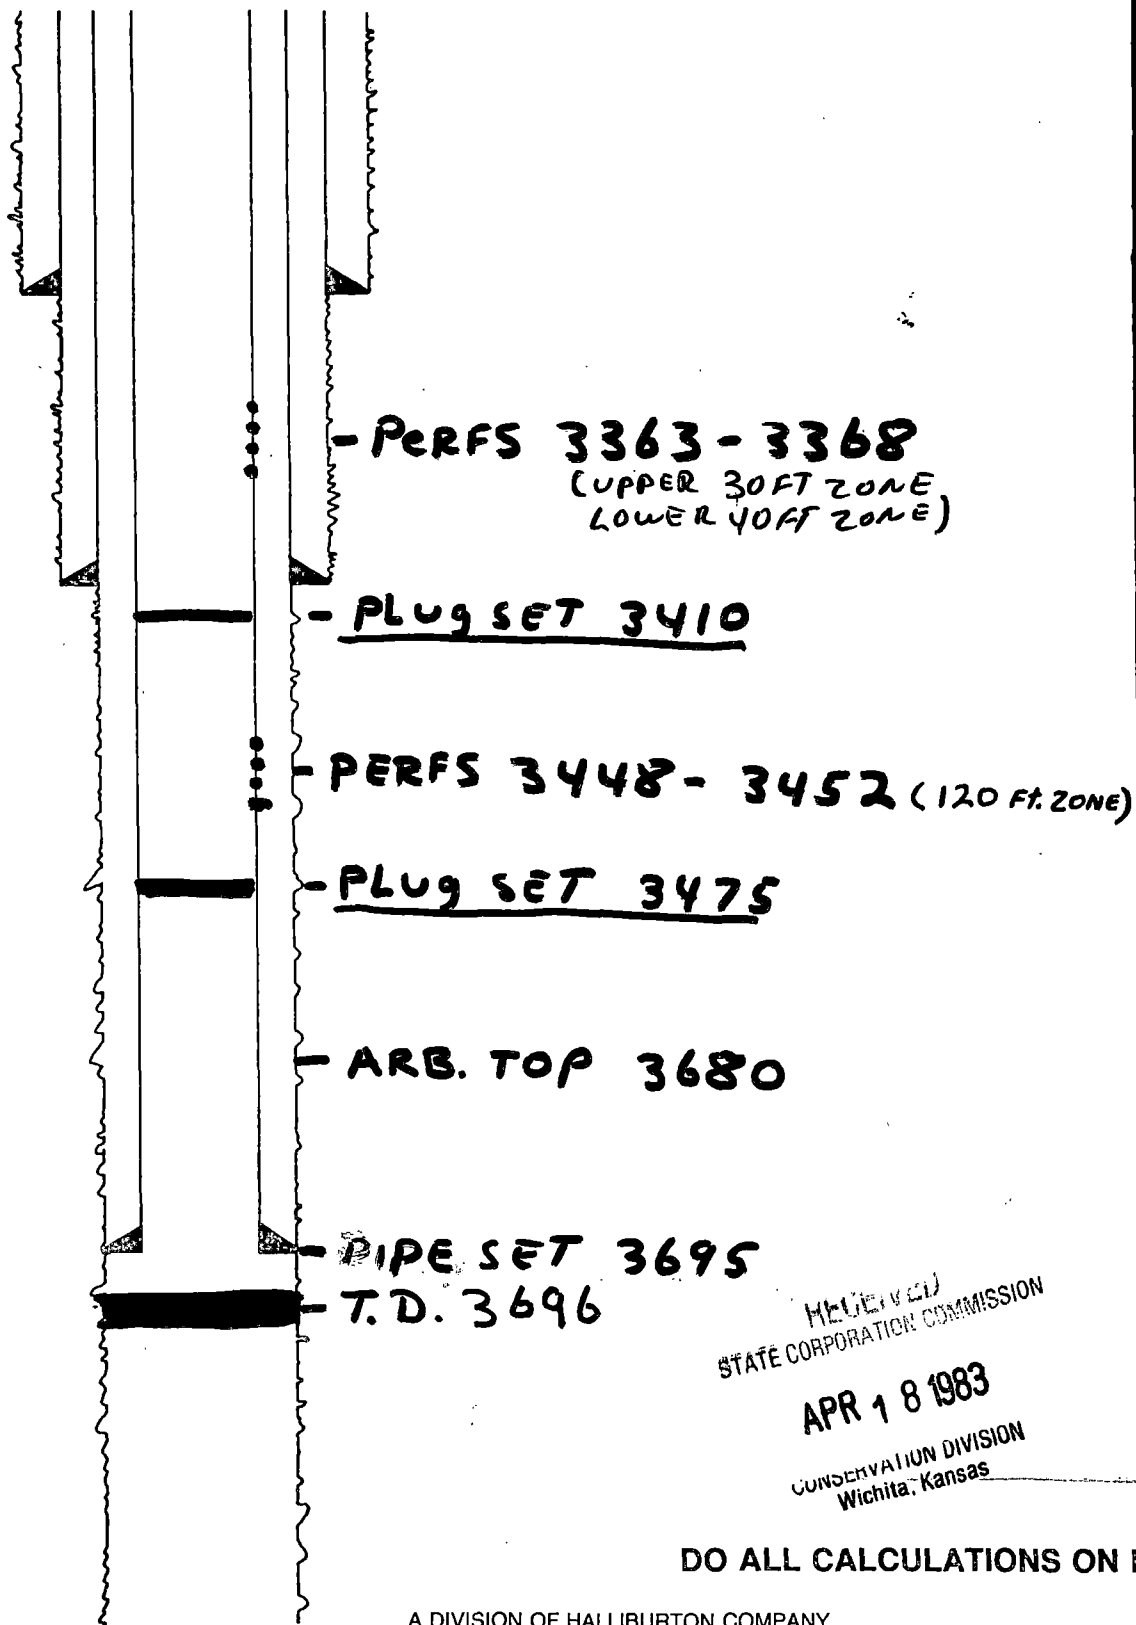

RECEIVED
STATE CORPORATION COMMISSION
APR 18 1983
CONSERVATION DIVISION
Wichita, Kansas

DO ALL CALCULATIONS ON E