

STATE OF KANSAS
STATE CORPORATION COMMISSION


WELL PLUGGING RECORD

*Give All Information Completely
Make Required Affidavit
Mail or Deliver Report to:
Conservation Division
State Corporation Commission
211 No. Broadway
Wichita, Kansas

Stafford County. Sec. 28 Twp. 21 Rge. (E) 13(W)

Location as "NE/CNW/SW" or footage from lines NE SW NW
Lease Owner Petroleum, Inc.
Lease Name Hufford A #6 Well No. _____
Office Address 352 North Broadway, Wichita, Kansas
Character of Well (completed as Oil, Gas or Dry Hole) oil
Date well completed _____ 19____
Application for plugging filed January 27 19 66
Application for plugging approved January 28 19 66
Plugging commenced February 16 19 66
Plugging completed February 25 19 66
Reason for abandonment of well or producing formation depleted

NORTH

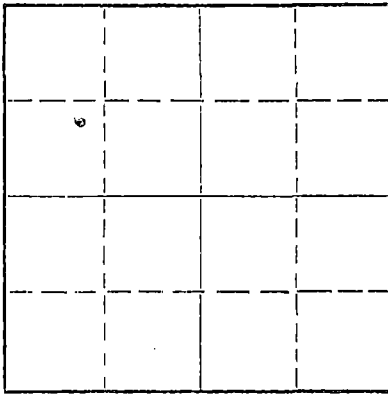

Locate well correctly on above
Section Plat

If a producing well is abandoned, date of last production _____ 19____
Was permission obtained from the Conservation Division or its agents before plugging was commenced? yes

Name of Conservation Agent who supervised plugging of this well Archie Elving
Producing formation _____ Depth to top _____ Bottom _____ Total Depth of Well 3737 Feet
Show depth and thickness of all water, oil and gas formations.

OIL, GAS OR WATER RECORDS

CASING RECORD

FORMATION	CONTENT	FROM	TO	SIZE	PUT IN	PULLED OUT
		0	204'	8 5/8"	204	none
		0	3729'	5 1/2"	3729	2915.30

Describe in detail the manner in which the well was plugged, indicating where the mud fluid was placed and the method or methods used in introducing it into the hole. If cement or other plugs were used, state the character of same and depth placed, from _____ feet to _____ feet for each plug set.

Pushed plug to 3375'. Set 10' rock bridge and dumped 15 gallons of sand. Mixed 5 sacks of cement and dumped at 3355'. Pushed plug to 204', set 10' rock bridge and mixed 6 sacks of cement and dumped at 194'. Would not bail down. Mixed 8 sacks of cement with calcium chloride and dumped on old plug. Bailed hole down. Dumped 17 sacks of cement. Filled hole with mud to 40'. Set 10' rock bridge and capped hole with 10 sacks of cement.

RECORDED
MAR 9 1966
KANSAS

(If additional description is necessary, use BACK of this sheet)
Name of Plugging Contractor Pipe Pullers, Inc.
Address Box 486, Ellinwood, Kansas

STATE OF Kansas, COUNTY OF Barton, ss.
Dean Wells (employee of owner) or (owner or operator) of the above-described well, being first duly sworn on oath, says: That I have knowledge of the facts, statements, and matters herein contained and the log of the above-described well as filed and that the same are true and correct. So help me God.

(Signature) Dean Wells
Ellinwood, Kansas
(Address)

SUBSCRIBED AND SWORN TO before me this 1st day of March, 19 66
J. J. Rader
Notary Public.

My commission expires July 7, 1968


WELL LOG BUREAU—KANSAS GEOLOGICAL SOCIETY
508 East Murdock, Wichita, Kansas

Company- PETRO., INC.
Farm- Hufford "A" No. 6

SEC. 28 T. 21 R. 13W
NE SW NW

Total Depth. 3737
Comm. 5-20-52 Comp. 6-2-52
Shot or.
Contractor. Garvey Drlg. Co.
Issued. 8-2-52

County Stafford
KANSAS

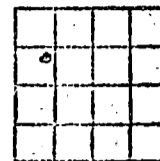

CASING:
8 5/8" 204' cem. w/125' sx
5 1/2" 3729'

Elevation. 1904

Production. 294 BO & NW

Figures indicate Bottom of Formations.

surface clay & sand	40
sand	100
sandstone	190
shale	204
shale & sand strks	355
red bed & shells	768
anhydrite	790
shale & shells	1600
lime & shale	1827
lime	1963
lime & shale	2172
lime	2290
lime & shale	2964
lime	3055
lime & shale	3216
lime	3254
lime & shale	3388
lime	3606
viola chert	3665
lime & shale	3702
lime	3737 RTD
Total Depth	

Tops:	
Heebner	3212
Brown Lime	3340
Lansing	3352
Viola	3612
Simpson	3663
Arbuckle	3727

RECEIVED
STATE CORPORATION COMMISSION
MAR 9 1966
CONSERVATION DIVISION
Wichita, Kansas