


WELL PLUGGING RECORD

Give All Information Completely
Make Required Affidavit
Mail or Deliver Report to:
Conservation Division
State Corporation Commission
800 Biring Building
Wichita, Kansas

Stafford County, Sec. 28 Twp. 21 Rge. 13 (E) W (W)
Location as "NE/CNW%SW%" or footage from lines NW NW SW
Lease Owner PETROLEUM, INC.
Lease Name P.L. KEENAN "A" Well No. 3
Office Address Route 2, Great Bend, Kansas
Character of Well (completed as Oil, Gas or Dry Hole) Oil
Date well completed July 13 19 51
Application for plugging filed July 26 19 56
Application for plugging approved July 27 19 56
Plugging commenced September 6 19 56
Plugging completed September 11 19 56
Reason for abandonment of well or producing formation Depletion of Producible zones
If a producing well is abandoned, date of last production July 26 19 56
Was permission obtained from the Conservation Division or its agents before plugging was commenced? Yes

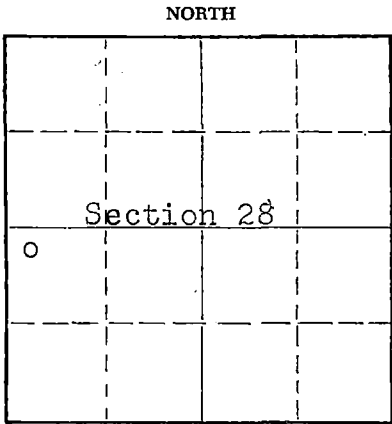

Locate well correctly on above Section Plat

Name of Conservation Agent who supervised plugging of this well R.M. Brundege, Hoisington, Kansas
Producing formation Arbuckle Depth to top 3728' Bottom -- Total Depth of Well 3777 Feet
Show depth and thickness of all water, oil and gas formations.

OIL, GAS OR WATER RECORDS

CASING RECORD

FORMATION	CONTENT	FROM	TO	SIZE	PUT IN	PULLED OUT
Arbuckle	Water & little oil	3729'	3732'	8 5/8" OD	225'	None
				5 1/2" OD	3776'	2940'

Describe in detail the manner in which the well was plugged, indicating where the mud fluid was placed and the method or methods used in introducing it into the hole. If cement or other plugs were used, state the character of same and depth placed, from _____ feet to _____ feet for each plug set.

(Plugged back to 3762')

Filled hole with crushed rock from 3762' to 3720', and placed 5 sacks cement on top of rock. Mudded up to 210' and made solid rock bridge on top mud. Placed 20 sacks cement on top of rock bridge and mudded up to 35'. Made solid rock bridge at 35' and filled hole to base of well cellar with 10 sacks cement.

(If additional description is necessary, use BACK of this sheet)

Name of Plugging Contractor Morgan Well Plugging Service
Address 102 West 18th Street, Hutchinson, Kansas

STATE OF KANSAS, COUNTY OF BARTON, ss.
DON SEARLE (employee of owner) or (~~owner or operator~~) of the above-described well, being first duly sworn on oath, says: That I have knowledge of the facts, statements, and matters herein contained and the log of the above-described well as filed and that the same are true and correct. So help me God.

(Signature) Don Searle
Route 2, Great Bend, Kansas
(Address)

SUBSCRIBED AND SWORN to before me this 14th day of September, 19 56

My commission expires July 11, 1960

Led A. Brown
Notary Public.

PLUGGING
FILE SEC 28 T 21 R 13W
BOOK PAGE 84 L.I.E. 11

WELL LOG P. L. KEENAN #3

Petroleum, Inc., Lease Owner

Sec. 28, Twp. 21S, Rge. 13W

Garvey Oil, Contractor

Location: NW NW SW.

Rotary Total Depth: 3778'

County: Stafford, Kansas

Commenced: June 23, 1951

Production: Arbuckle

Completed: July 7, 1951

Elevation: 1922 R.B.

Casing: 221' of 8 5/8"
3777' of 5 1/8"

All figures below indicate bottom of formation:

130	Sand & Gravel
221	Blue Shale & Shells
270	Shale
290	Sand & Shale
450	Shale & Red Bed
785	Red Bed
815	Anhydrite
1560	Shale & Shells
2075	Lime & Shale
2175	Shale & Shells
3095	Lime & Shale
3208	Lime
3378	Lime & Shale
3607	Lime
3638	Lime & Shale
3650	Chert
3680	Shale
3705	Lime
3727	Shale
3778	Lime

Tops:

785	Anhydrite
3238	Keebner
3367	Brown Lime
3378	Lansing
3598	B.K.C.
3632	Cong.
3728	Arbuckle

DST #1 3390-3410, open 1 hr., rec. 45' oil cut mud.
 DST #2 3575-3680, open 45 mins. rec. 30' mud.
 DST #3 3729-33, open 1 hour. rec. 420' oil, BHP 1025#

3778' R.T.D.

PLUGGING
 FILE SEC 28 T 21 R 13w
 BOOK PAGE 84 LINE 11

I hereby certify that this is a true and correct log of the above mentioned well.

PETROLEUM, INC.

STATE OF KANSAS :
 : SS.
 COUNTY OF SEDGWICK:

Eric H. Jager

 Eric H. Jager

Subscribed to and sworn to before me, a Notary Public, in said county and state, this 17th day of July, 1951.

Charlotte Heidman

 Notary Public

My commission expires: 10-13-54