

STATE OF KANSAS
STATE CORPORATION COMMISSION


WELL PLUGGING RECORD

Give All Information Completely
Make Required Affidavit
Mail or Deliver Report to:
Conservation Division
State Corporation Commission
800 Bitting Building
Wichita, Kansas

OR
FORMATION PLUGGING RECORD

Strike out upper line
when reporting plugging
off formations.

NORTH

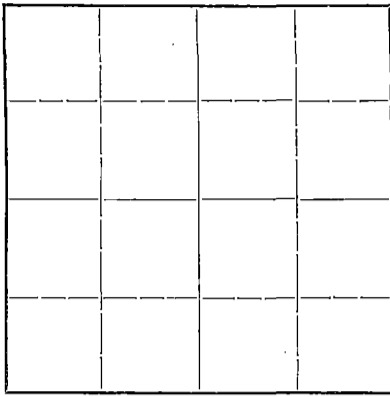

Locate well correctly on above
Section Plat

Stafford County. Sec. 28 Twp. 21 Rge. (E) 21 (W)

Location as "NE 1/4 NW 1/4 SW 1/4" or footage from lines. Center E 1/2 NE 1/4 NW 1/4

Lease Owner W. P. Faulkner

Lease Name Hufford Well No. 1

Office Address Mark Twain Hotel, St. Louis, Missouri

Character of Well (completed as Oil, Gas or Dry Hole) Dry

Date well completed July 29 19 42

Application for plugging filed July 29 19 42

Application for plugging approved July 29 19 42

Plugging commenced July 29 19 42

Plugging completed July 29 19 42

Reason for abandonment of well or producing formation Dry

If a producing well is abandoned, date of last production 19

Was permission obtained from the Conservation Division or its agents before plugging was commenced? Yes

Name of Conservation Agent who supervised plugging of this well Alexander

Producing formation Depth to top Bottom Total Depth of Well Feet

Show depth and thickness of all water, oil and gas formations.

OIL, GAS OR WATER RECORDS

CASING RECORD

Formation	Content	From	To	Size	Put In	Pulled Out
				10 3/4"	204'	None

Describe in detail the manner in which the well was plugged, indicating where the mud fluid was placed and the method or methods used in introducing it into the hole. If cement or other plugs were used, state the character of same and depth placed, from feet to feet for each plug set.

Pumped heavy rotary mud in hole before laying down drill pipe. Circulated hole every 500' while laying down drill pipe.

Mud from 3806' to 204'


Set bridge at 204'

Cement from 204' to 174'

Mud from 174' to 26'

Bridge set at 26', Cement from 26' to 6'

Cement was run in hole through drill pipe.

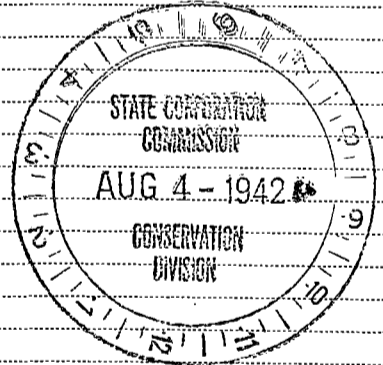

PLUGGING
FILE REC 28 21-13W
BOOK PAGE 45 LINE 2

(If additional description is necessary, use BACK of this sheet)

Correspondence regarding this well should be addressed to W. P. Faulkner, Mark Twain Hotel, St. Louis, Mo.

Address

STATE OF Kansas, COUNTY OF Sedgwick, SS.
Sam Payne, Jr. employ of ~~custodian~~ *custodian* of the above-described well,
being first duly sworn on oath, says: That I have knowledge of the facts, statements, and matters herein contained and the log of the above-described well as filed and that the same are true and correct. So help me God.

(Signature) Sam Payne, Jr.

713 First Nat'l. Bldg., Wichita, Kansas
(Address)

SUBSCRIBED AND SWORN to before me this 31st day of July, 19 42

My commission expires March 30, 1944

Sibyl Sued
Notary Public.

15.185.11523.0000

HUFFORD WELL NO. 1

Location: Center of E 1/2 NE 1/4 NW 1/4 28-21S-13W, Stafford County, Kansas
 Owner: W. P. Faulkner Commenced: 7-13-42
 Contractor: Simpson & Noble, Inc. Completed: 7-29-42
 Csg. Record: 10 3/4" @ 204' Total Depth: 3806'
 Dry Hole

LOG

Clay & sand	100
Sand Rock	130
Blue shale, shells & Pyrites	204
Shale	390
Red Bed	785
Anhydrite	805
Shale & Shells	1290
Salt & Shells	1520
Shale & Shells	1690
Lime & Shale Streaks	1780
Lime & shale breaks	1830
Lime & Chert	1837
Shale & Shells	1851
Broken Lime	1950
Lime	2065
Broken Lime	2120
Shale & Lime Shells	2135
Broken Lime	2160
Lime	2196
Lime & Shale Breaks	2306
Broken Lime	2730
Shale & Lime	2799
Broken Lime	2814
Shale	2885
Shale & Lime	2925
Broken Lime--Topeka	2987
Lime	3067
Lime Broken	3137
Broken Lime & Chert	3184
Lime & Shale Breaks	3246
Lime & Chert	3288
Broken Lime, Kansas City	3375
Shale & Lime	3450
Lime Broken, Shale, Kansas City	3500
Broken Kansas City Lime	3539
Kansas City Lime	3620
Lime	3666
Broken Lime	3707
Conglomerale	3718
Lime	3731
Shale & Lime	3734
Shale	3776
Lime & Shale	3794
Arbuckle Lime	3806

28-21-13W
 4.5 LINE 2

