

R


Give All Information Completely  
Make Required Affidavit  
Mail or Deliver Report to:  
Conservation Division  
State Corporation Commission  
251 No. Broadway  
Wichita, Kansas

WELL PLUGGING RECORD

Stafford County, Sec. 28 Twp. 21 Rge. (E) 13(W)

Location as "NE/CNW/KSWK" or footage from lines SE SW NW  
Lease Owner Great Bend Pipe & Supply  
Lease Name H. C. Hufford Well No. 1  
Office Address Great Bend, Kansas  
Character of Well (completed as Oil, Gas or Dry Hole) Oil  
Date well completed 19  
Application for plugging filed 19  
Application for plugging approved 19  
Plugging commenced 9-28-60 19  
Plugging completed 10-4-60 19  
Reason for abandonment of well or producing formation

NORTH

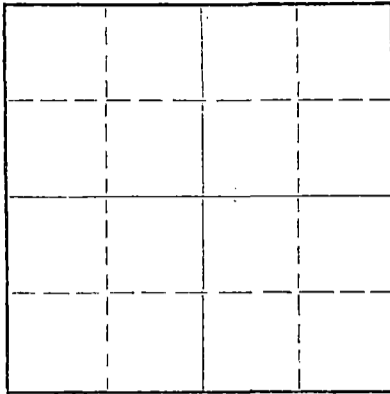

Locate well correctly on above Section Plat

If a producing well is abandoned, date of last production 19  
Was permission obtained from the Conservation Division or its agents before plugging was commenced? yes

Name of Conservation Agent who supervised plugging of this well Frank Broadfoot  
Producing formation Depth to top Bottom Total Depth of Well 3713 Feet  
Show depth and thickness of all water, oil and gas formations.

OIL, GAS OR WATER RECORDS

CASING RECORD

FORMATION	CONTENT	FROM	TO	SIZE	PUT IN	PULLED OUT
				8 5/8"	205	none
				5 1/2"	3703	3012'

Describe in detail the manner in which the well was plugged, indicating where the mud fluid was placed and the method or methods used in introducing it into the hole. If cement or other plugs were used, state the character of same and depth placed, from feet to feet for each plug set.

Sanded to 3685' dumped 5 sks cement-mudded hole to 200'-bailed fluid down-set 10' rock bridge-dumped 20 sks cement-mudded to 35'-set 10' rock bridge-dumped 10 sks cement.

RECEIVED  
STATE CORPORATION COMMISSION  
NOV 21 1960  
CONSERVATION DIVISION  
Wichita, Kansas

(If additional description is necessary, use BACK of this sheet)  
Name of Plugging Contractor R. & D. Casing Pulling Co. License #236  
Address Box 154, Ellinwood, Kansas

STATE OF Kansas COUNTY OF Barton, ss.  
Nathan Meltzer (employee of owner) or (owner or operator) of the above-described well, being first duly sworn on oath, says: That I have knowledge of the facts, statements, and matters herein contained and the log of the above-described well as filed and that the same are true and correct. So help me God.

(Signature) *Nathan Meltzer*  
Box 191, Great Bend, Kansas (Address)

SUBSCRIBED AND SWORN TO before me this 18 day of November, 1960

My commission expires 3/30/61

*Anne Meltzer*  
Anne Meltzer Notary Public.



*B*  
WELL LOG HUFFORD NO. 1

Petroleum, Inc., Lease Owner

Section 28, Twp. 21S, Rge. 13W

Drillers, Inc., Contractor

Location: SE SW NW

Rotary Total Depth: 3711'

County: Stafford, Kansas

Commenced: December 31, 1949

Production:

Completed: January 13, 1950

Elevation: 1913 D.F.

Casing: 218.08' of 8 5/8"  
3726.07' of 5 1/2"

## FIGURES BELOW INDICATE BOTTOM OF FORMATION

	<u>Tops</u>
80 Shale & Sand	790 Anhydrite
110 Sand & Gravel	3228 Heebner
125 Iron	3247 Toronto
205 Shale & Lime Shells	3358 Brown Lime
275 Shale & Shells	3369 Lansing
370 Sand	3629 Viola
680 Red Bed	3659 Simpson
820 Anhydrite	3797 Arbuckle
1465 Shale & Shells	
1765 Lime & Shale	
1890 Lime	
2225 Lime & Shale	
3195 Lime	
3262 Shale & Lime	
3358 Shale	
3395 Lime	
3665 Viola (Chert)	
3674 Shale	
3708 Lime	

3711 R.T.D.

RECEIVED  
STATE CORPORATION COMMISSION

OCT 4 1950

CONSERVATION DIVISION  
Wichita, Kansas

I hereby certify that this is a true and correct log of the above mentioned well.

PETROLEUM, INC.

*Eric H. Jager*  
Eric H. Jager

STATE OF KANSAS  
|  
| SS.  
|  
SEDGWICK COUNTY

Subscribed to and sworn to before me, a Notary Public in said County and State this 20th day of January, 1950.

*Margorie Bradshaw*  
Notary Public

My commission expires: October 27, 1952.