


WELL PLUGGING RECORD

Give All Information Completely
Make Required Affidavit
Mail or Deliver Report to:
Conservation Division
State Corporation Commission
212 No. Market
Wichita, Kansas

Stafford County. Sec. 28 Twp. 21 Rge. (E) 13 (W)
Location as "NE/CNW/SW" or footage from lines. SW NW NW

Lease Owner Petroleum, Inc. (Hufford A-7)
Lease Name Hazel South Flood Unit #2-1 Well No.
Office Address 352 North Broadway, Wichita, Kansas
Character of Well (completed as Oil, Gas or Dry Hole) oil
Date well completed _____ 19____
Application for plugging filed January 27 19 66
Application for plugging approved _____ 19____
Plugging commenced February 18 19 66
Plugging completed February 23 19 66
Reason for abandonment of well or producing formation depleted

NORTH

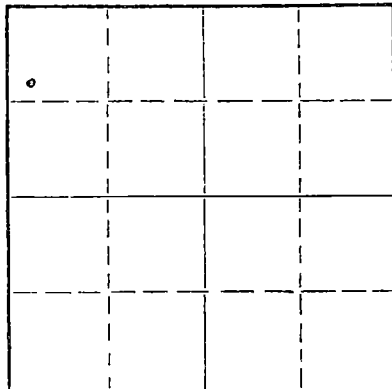

Locate well correctly on above
Section Plat

If a producing well is abandoned, date of last production _____ 19____
Was permission obtained from the Conservation Division or its agents before plugging was commenced? yes

Name of Conservation Agent who supervised plugging of this well Archie Elving
Producing formation _____ Depth to top _____ Bottom _____ Total Depth of Well 3755 Feet
Show depth and thickness of all water, oil and gas formations.

OIL, GAS OR WATER RECORDS

CASING RECORD

FORMATION	CONTENT	FROM	TO	SIZE	PUT IN	PULLED OUT
		0	215'	8 5/8"	215	none
		0	3754'	5 1/2"	3754	3114.40

Describe in detail the manner in which the well was plugged, indicating where the mud fluid was placed and the method or methods used in introducing it into the hole. If cement or other plugs were used, state the character of same and depth placed, from _____ feet to _____ feet for each plug set.

Pushed plug to 3380'. Dumped 10' of egg rock and 10 gallons of sand. Mixed 5 sacks of cement and dumped at 3365'. Pushed plug to 200', set 10' rock bridge and 10 gallons of sand. Bailed hole down and dumped 27 sacks of cement. Filled hole with mud to 30', set 3' rock bridge and capped hole with 10 sacks of cement.

RECEIVED
MAR 9 1966

MAR 9 1966

CONSERVATION DIVISION
Wichita, Kansas

(If additional description is necessary, use BACK of this sheet)
Name of Plugging Contractor Pipe Pullers, Inc.
Address Box 486, Ellinwood, Kansas

STATE OF Kansas, COUNTY OF Barton, ss.
Dean Wells (employee of owner) or (~~owner or operator~~) of the above-described

well, being first duly sworn on oath, says: That I have knowledge of the facts, statements, and matters herein contained and the log of the above-described well as filed and that the same are true and correct. So help me God.

(Signature) Dean Wells

Ellinwood, Kansas
(Address)

SUBSCRIBED AND SWORN TO before me this 1st day of March, 19 66

[Signature]
Notary Public.

My commission expires July 7, 1968


WELL LOG BUREAU—KANSAS GEOLOGICAL SOCIETY
508 East Murdock, Wichita, Kansas

Company. PETROLEUM, INC.
Farm. Hufford "A" No. 7

SEC. 28 T. 21 R. 13W
SW NW NW

Total Depth. 3758
Comm. 4-29-53 Comp. 5-10-53
Shot or Treated.
Contractor Garvey Drilling Co.
Issued. 8-1-53

County Stafford
KANSAS

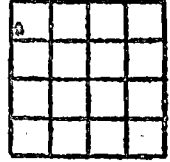

Elevation. 1915

Production. Pump 75 BO, 15 BW

CASING:

8 5/8 set at 215' w/ 200 sx cement
5 1/2 set at 3754' w/ 75 sx cement

Figures indicate Bottom of Formations.

sand	124
sand & shale	160
shale	215
shale & shells	360
red bed	776
anhydrite	808
shale & shells	1575
lime & shale	2570
lime, shale & shells	2730
lime & shale	3268
shale	3282
lime & shale	3379
lime	3618
lime & shale	3662
shale & sand	3505
lime	3758
Total Depth	RTD 3755

TOPS:	
Heebner	3232
Brown lime	3362
Lansing	3374
Arbuckle	3705

RECEIVED
STATE CORPORATION COMMISSION

MAR 9 1966

PRESERVATION DIVISION
Wichita, Kansas