


STATE OF KANSAS
STATE CORPORATION COMMISSION

Give All Information Completely
Make Required Affidavit
Mail or Deliver Report to:
Conservation Division
State Corporation Commission
800 Bitting Building
Wichita, Kansas

WELL PLUGGING RECORD

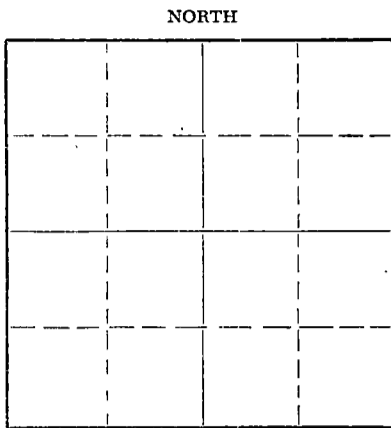

Locate well correctly on above
Section Plat

Stafford County. Sec. 28 Twp. 21 Rge. 13 (~~XX~~) (W)
Location as "NE/CNW/SW" or footage from lines NW SE SW
Lease Owner Petroleum, Inc.
Lease Name P. L. Keenan 'A' Well No. 4
Office Address 305 E. Third, Wichita 2, Kansas
Character of Well (completed as Oil, Gas or Dry Hole) Dry Hole
Date well completed June 19, 19 52
Application for plugging filed June 19, 19 52
Application for plugging approved June 19, 19 52
Plugging commenced June 19, 19 52
Plugging completed June 19, 19 52
Reason for abandonment of well or producing formation Dry Hole

If a producing well is abandoned, date of last production _____ 19 ____
Was permission obtained from the Conservation Division or its agents before plugging was commenced? Yes

Name of Conservation Agent who supervised plugging of this well Mr. M. A. Rives
Producing formation _____ Depth to top _____ Bottom _____ Total Depth of Well 3787 Feet
Show depth and thickness of all water, oil and gas formations.

OIL, GAS OR WATER RECORDS

CASING RECORD

FORMATION	CONTENT	FROM	TO	SIZE	PUT IN	PULLED OUT
				8 5/8"	210'	None

Describe in detail the manner in which the well was plugged, indicating where the mud fluid was placed and the method or methods used in introducing it into the hole. If cement or other plugs were used, state the character of same and depth placed, from _____ feet to _____ feet for each plug set.

Mudded up to 210' and set wooden plug at 210'.

Cemented and displaced 20 sacks cement through

drill pipe on top of plug at 210'. Mudded up to

40' and set second wooden plug. Filled hole to

bottom of well cellar with 10 sacks cement.

(If additional description is necessary, use BACK of this sheet)

Name of Plugging Contractor Garvey Drilling Company
Address R. R. #2, Great Bend, Kansas

STATE OF KANSAS, COUNTY OF SEDGWICK, ss.
W. W. Fisher (employee of owner) ~~or (owner or operator)~~ of the above-described well, being first duly sworn on oath, says: That I have knowledge of the facts, statements, and matters herein contained and the log of the above-described well as filed and that the same are true and correct. So help me God.

(Signature) W W Fisher

305 East Third, Wichita 2, Kansas

(Address)

SUBSCRIBED AND SWORN to before me this 3rd day of July, 19 52.

My commission expires October 13, 1954.

[Signature]
Notary Public.

PLUGGING
SEC 28 T 21 R 13
WICHITA 2, KANSAS
DATE 25 LINE 2

24-2675-S
2-52-20M
JUL - 7 1952
CONSERVATION DIVISION
Wichita, Kansas

DRILLER'S LOG P.L. KEENAN 'A' #4

Operator, Petroleum, Inc.	Section 28, Twp. 21S, Rge. 13W
Contractor, Garvey Drilling Co.	Location: NW SE SW
Drilling Commenced: June 10, 1952	County: Stafford County, Ks.
Drilling Completed: June 19, 1952	R.T.D.: 3787'
Casing Records: 8 5/8" @ 210' w/175 sax	Production: D & A

Figures below indicate bottom of formation:

40	Sand	
1730	Shale & Shells	Tops:
1885	Lime & Shale	Heebner: 3251 (-1348)
2610	Shale & Shells	Brown Lime: 3379 (-1476)
2840	Shale & Lime	Lansing: 3391 (-1486)
3232	Lime & Shale	Conglomerate: 3657 (-1754)
3320	Lime	Simpson sh.: 3755 (-1852)
3425	Lime & Shale	
3590	Lime	
3647	Lime Viola	DST #1, 3680-3750, open 1 hour, rec.
3695	Chert Conglomerate	30' mud, 0# BHP.
3705	Chert, Shale & Sand	
3775	Shale & Lime	
3787	Shale	
3787'	R.T.D.	

I hereby certify that this is a true and correct log of the above mentioned well.

PETROLEUM, INC.

By W.W. Fisher

STATE OF KANSAS)
) SS:
 COUNTY OF SEDGWICK)

Subscribed to and sworn to before me, a Notary Public in said County and State, this 3rd day of July, 1952.

Charlotte Heisman
 Notary Public
 STATE CORPORATIONS COMMISSION

My commission expires: October 13, 1954. JUL - 7 1952

PLUGGING
 SEC 28 T 21 R 13
 NOT 25 11/1/52

CONSERVATION DIVISION
Wichita, Kansas