

STATE OF KANSAS
STATE CORPORATION COMMISSION


Give All Information Completely
Make Required Affidavit
Mail or Deliver Report to:
Conservation Division
State Corporation Commission
211 No. Broadway
Wichita, Kansas

WELL PLUGGING RECORD

Stafford County, Sec. 3 Twp. 21 Rge. (E) 11 (W)

Location as "NE/CNW%SW%" or footage from lines App E/2 SE NW
Lease Owner F. G. Holl
Lease Name Snider Well No. #1
Office Address 6427 E. Kellogg, Wichita, Kansas
Character of Well (completed as Oil, Gas or Dry Hole) oil
Date well completed 19
Application for plugging filed April 19 19 63
Application for plugging approved 19
Plugging commenced April 24 19 63
Plugging completed April 29 19 63
Reason for abandonment of well or producing formation depleted

NORTH

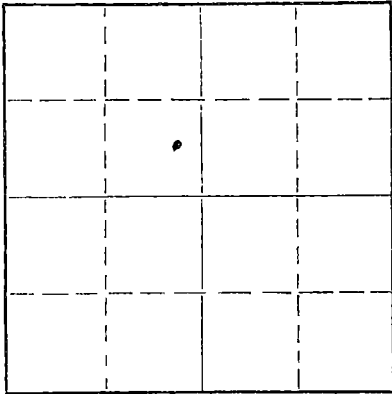

Locate well correctly on above
Section Plat

If a producing well is abandoned, date of last production 19
Was permission obtained from the Conservation Division or its agents before plugging was com-
menced? yes

Name of Conservation Agent who supervised plugging of this well W. L. Lackamp
Producing formation Depth to top Bottom Total Depth of Well 3400 Feet
Show depth and thickness of all water, oil and gas formations.

OIL, GAS OR WATER RECORDS

CASING RECORD

FORMATION	CONTENT	FROM	TO	SIZE	PUT IN	PULLED OUT
		0	255	8 5/8	255	none
		0	3439	4 1/2	3439	2000.58

Describe in detail the manner in which the well was plugged, indicating where the mud fluid was placed and the method or methods used in introducing it into the hole. If cement or other plugs were used, state the character of same and depth placed, from feet to feet for each plug set.

Pushed plug to 3100', set 10' rock bridge. Mixed 3 sacks of cement and dumped at 3090'. Set plug at 225', set 10' rock bridge. Mixed 3 sacks of cement and dumped at 215'. Let set all night. Bail hole down to 200', dump 17 sacks of cement. Fill with mud to 40', set 10' rock bridge and cap with 10 sacks of cement. Plugged at 11:30 a.m.

RECEIVED
STATE CORPORATION COMMISSION

MAY 6 1963

CONSERVATION DIV
Wichita, Kansas

(If additional description is necessary, use BACK of this sheet)

Name of Plugging Contractor Pipe Pullers, Inc.
Address Box 486, Ellinwood, Kansas

STATE OF Kansas, COUNTY OF Barton, ss.
Dean Wells (employee of owner) or (owner or operator) of the above-described well, being first duly sworn on oath, says: That I have knowledge of the facts, statements, and matters herein contained and the log of the above-described well as filed and that the same are true and correct. So help me God.

(Signature) *Dean Wells*

Ellinwood, Kansas

(Address)

SUBSCRIBED AND SWORN TO before me this 2nd day of May, 1963

J. Rader

My commission expires July 7, 1964

Notary Public.



CONTRACTOR'S WELL LOG

COMPANY:
CONTRACTOR:
FARM:
LOCATION:

COMMENCED:
COMPLETED:

Leben Drilling, Inc.
Leben Drilling, Inc.
Snider No. 1
C-E/2 SE NW Sec. 3-21-11
Stafford County, Kansas
January 31, 1956
February 17, 1956

0	30	Surface Clay
30	257	Sand and Redbed
257	370	Redbed
370	490	Shale, shells
490	515	Anhydrite
515	800	Shale, shells
800	1100	Shale, salt
1100	1325	Shale, shells
1325	1585	Shale, lime
1585	2096	Lime, shale
2096	2245	Shale, lime
2245	2410	Shale, shells
2410	2680	Shale, lime
2680	2780	Lime
2780	2885	Lime, shale
2885	3072	Shale, lime
3072	3100	Lantz
3100	3150	Lime
3150	3275	Lime, shale
3275	3335	Lime
3335	3400	Conglomerate
	<u>3400</u>	<u>Rotary Total Depth, D & A</u>

Set 264.87 feet of 8 5/8" surface casing @ 255.87 feet w/175 sacks cement.

I, James M. Battin, do hereby certify that the above and foregoing is a true and correct copy of the log of the Snider No. 1, C-E/2 SE NW Sec. 3-21-11, Stafford County, Kansas as reflected by the files of Leben Drilling, Inc.

LEBEN DRILLING, INC.

BY: James M. Battin

STATE OF KANSAS)
COUNTY OF SEDGWICK) SS

Subscribed and sworn to before me, a Notary Public, indand for Sedgwick County, Kansas, this 22nd day of February, 1956.

Norma D. Lussion
Notary Public

My commission expires April 20, 1959

RECEIVED
SHERIFF'S OFFICE
FEB 23 1956
CONSERVATOR OF PUBLIC LANDS
Wichita, Kansas

PLUGGING
FILE SEC 3-21-11W
BOOK PAGE 40 LINE 23
39