


STATE OF KANSAS
STATE CORPORATION COMMISSION

WELL PLUGGING RECORD

Give All Information Completely
Make Required Affidavit
Mail or Deliver Report to:
Conservation Division
State Corporation Commission
212 No. Market
Wichita, Kansas

Stafford County. Sec. 3 Twp. 21S Rge. 11 (W)
Location as "NE/CNW/SW" or footage from lines SE SW SE
Lease Owner Nadel and Gussman
Lease Name Snyder Well No. 1
Office Address 1714 First National Bldg., Tulsa 3, Oklahoma
Character of Well (completed as Oil, Gas or Dry Hole) Oil Well
Date well completed January 9, 1961
Application for plugging filed June 29, 1961
Application for plugging approved June 30, 1961
Plugging commenced July 3, 1961
Plugging completed July 6, 1961
Reason for abandonment of well or producing formation non-commercial

NORTH

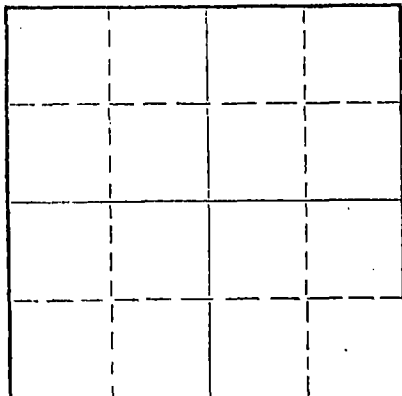

Locate well correctly on above
Section Plat

If a producing well is abandoned, date of last production 19
Was permission obtained from the Conservation Division or its agents before plugging was commenced? Yes

Name of Conservation Agent who supervised plugging of this well Frank Boradfoot
Producing formation Depth to top Bottom Total Depth of Well 3350 Feet
Show depth and thickness of all water, oil and gas formations.

OIL, GAS OR WATER RECORDS

CASING RECORD

FORMATION	CONTENT	SIZE	PUT IN	PULLED OUT
		8 5/8	253	
	12-19-66	5 1/2	3345	2400

Describe in detail the manner in which the well was plugged, indicating where the mud fluid was placed and the method or methods used in introducing it into the hole. If cement or other plugs were used, state the character of same and depth placed, from feet to feet for each plug set.

Set Baker plug at 2550 feet. Filled hole with sand and cement to 2500 feet. Pulled 2400 feet of 5 1/2 inch pipe. Filled hole with mud to 200 feet. Set rock bridge with 20 sacks of cement. Mudded hole to 40 feet; set rock bridge with 10 sacks of cement to base of cellar.

(If additional description is necessary, use BACK of this sheet)

Name of Plugging Contractor Forbes Casing Pulling Company
Address Great Bend, Kansas

STATE OF Oklahoma, COUNTY OF Tulsa, ss.
M. R. Taylor (employee of owner) or (owner or operator) of the above-described well, being first duly sworn on oath, says: That I have knowledge of the facts, statements, and matters herein contained and the log of the above-described well as filed and that the same are true and correct. So help me God.

(Signature) M R Taylor
1714 First National Building, Tulsa, Okla.
(Address)

SUBSCRIBED AND SWORN TO before me this 16th day of December, 1966

My commission expires September 21, 1969

June M. Dorsow
Notary Public.

STATE OF KANSAS
STATE CORPORATION COMMISSION

Give All Information Completely
Make/Required Affidavit
Mail or Deliver Report to:
Conservation Division
State Corporation Commission
211 No. Broadway
Wichita, Kansas

15.185.19551.0000
WELL PLUGGING RECORD

Stafford County. Sec. 3 Twp. 21 Rge. 11W (E) (W)

Location as "NE/CNW&SW" or footage from lines SE SW SE

Lease Owner Nadel and Gussman

Lease Name Snyder Well No. # 1

Office Address P. O. Box 14 Great Bend, Kansas

Character of Well (completed as Oil, Gas or Dry Hole) _____

Date well completed _____ 19__

Application for plugging filed yes _____ 19__

Application for plugging approved yes _____ 19__

Plugging commenced 7-3-61 _____ 19__

Plugging completed 7-6-61 _____ 19__

Reason for abandonment of well or producing formation _____

If a producing well is abandoned, date of last production _____ 19__

Was permission obtained from the Conservation Division or its agents before plugging was commenced? yes

Name of Conservation Agent who supervised plugging of this well Frank Broadfoot

Producing formation _____ Depth to top _____ Bottom _____ Total Depth of Well PB 2430' Feet

Show depth and thickness of all water, oil and gas formations.

OIL, GAS OR WATER RECORDS

CASING RECORD

FORMATION	CONTENT	FROM	TO	SIZE	PUT IN	PULLED OUT
				5 1/2"	3350'	2420'

Describe in detail the manner in which the well was plugged, indicating where the mud fluid was placed and the method or methods used in introducing it into the hole. If cement or other plugs were used, state the character of same and depth placed, from _____ feet to _____ feet for each plug set.

Plugging commenced 7-3-61. Plugging completed 7-6-61.

Measured total depth: 2430'.

Plugged off bottom: Dumped 5 sacks cement on bottom.

Worked and shot 5 1/2" casing free at 2420'. Built rack and slide. Pulled and layed down casing.

Plugged well: Mudded up to 250' and dumped 20 sacks of cement, on rock bridge at 250'. Mudded up to 35' and set 10' rock bridge at 35'. Capped the well with 10 sacks of cement.

RECEIVED
STATE CORPORATION COMMISSION

AUG 16 1961

(If additional description is necessary, use BACK of this sheet)

Name of Plugging Contractor Forbes Casing Pulling, Inc. Conservation Division
Address P. O. Box 221 Great Bend, Kansas Wichita, Kansas

STATE OF Kansas, COUNTY OF Barton, ss.
J. O. Forbes (employee of owner) or (owner or operator) of the above-described well, being first duly sworn on oath, says: That I have knowledge of the facts, statements, and matters herein contained and the log of the above-described well as filed and that the same are true and correct. So help me God.

(Signature) J. O. Forbes
Great Bend, Kansas
(Address)

SUBSCRIBED AND SWORN TO before me this 7th day of July, 19 61

My commission expires December 8th, 1963

Kayann Jenkins
Notary Public.



WELL LOG

Date started 12-31-60
Date completed 1-9-61

8.5/8" Surface Pipe set at 253' cemented with 220 sacks of incore cement. Run 111 joints of 5 1/2" OD 15.50 #SS Casing; set at 3345' cemented with 100 sacks of regular cement.

Snyder #1
Section 3, Township 21, Range 11W
Stafford County, Kansas

Elevation	1766' KB
Anhydrite	460' (+1306)
Heebner	2915' (-1149)
Brown Lime	3049' (-1283)
Lansing line	3062' (-1296)
Arbuckle Dohmite	3333' (-1567)
Total depth	3350' (-1584)

- 0' - 190' Sand
- 190' - 252' Shale and shells
- 252' - 460' Shale and redbed
- 460' - 495' Anhydrite
- 495' - 1240' Shale and shells
- 1240' - 3095' Lime and shale
- 3095' - 3157' Lime
- 3157' - 3295' Lime and shale
- 3295' - 3330' Conglomerate
- 3330' - 3350' Arbuckle

RECEIVED
STATE CORPORATION COMMISSION

JUN 30 1961

CONSERVATION DIVISION
Wichita, Kansas

AFFIDAVIT

State of Kansas County of Barton

I, A. M. Jones, certify that the above is a true and correct lot as reflected by the Daily drilling reports of the Jones Drilling Company.

By: A. M. Jones

Subscribed and sworn before me this 14th day of January, 1961.

John W. Poos
John W. Poos Notary Public

My commission expires April 11, 1963.