

STATE OF KANSAS
STATE CORPORATION COMMISSION

WELL PLUGGING RECORD
OR
FORMATION PLUGGING RECORD


Strike out upper line when reporting plugging off formations.

Give All Information Completely
Make Required Affidavit
Mail or Deliver Report to:
Conservation Division
State Corporation Commission
800 Bittling Building
Wichita, Kansas

Stafford County, Sec. 3 Twp. 21 SRge. (E) 11 (W)

Location as "NE $\frac{1}{4}$ NW $\frac{1}{4}$ SW $\frac{1}{4}$ " or footage from lines 330' S- 330' W of Center
Lease Owner Cities Service Oil Co.
Lease Name Sifers "A" Well No. 1
Office Address Bartlesville, Oklahoma
Character of Well (completed as Oil, Gas or Dry Hole) Oil
Date well completed July 1, 1936
Application for plugging filed January 5, 1942
Application for plugging approved January 6, 1942
Plugging commenced January 29, 1942
Plugging completed February 10, 1942
Reason for abandonment of well or producing formation Unprofitable

NORTH

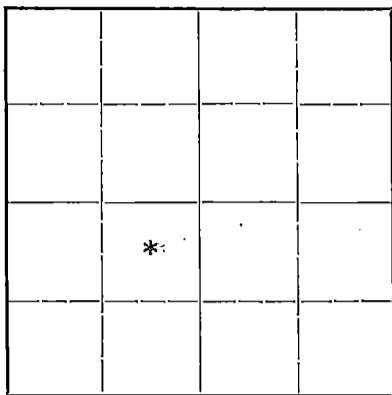

Locate well correctly on above Section Plat

If a producing well is abandoned, date of last production January 1, 1942
Was permission obtained from the Conservation Division or its agents before plugging was commenced? YES

Name of Conservation Agent who supervised plugging of this well C. T. Alexander
Producing formation Arbuckle Depth to top 3324' Bottom 3343' Total Depth of Well 3343 Feet
Show depth and thickness of all water, oil and gas formations.

OIL, GAS OR WATER RECORDS

CASING RECORD


Formation	Content	From	To	Size	Put In	Pulled Out
	Cemented with		300 sx.	15 $\frac{1}{8}$ "	210'	0
	" "		100 Sx.	12 $\frac{3}{8}$ "	301'	0
	" "		250 Sx.	8 5/8"	3065'	1780'
	Not Cemented			7"	3193'	3033'
	" "			5 $\frac{1}{8}$ "	153' 10"	0

Describe in detail the manner in which the well was plugged, indicating where the mud fluid was placed and the method or methods used in introducing it into the hole. If cement or other plugs were used, state the character of same and depth placed, from _____ feet to _____ feet for each plug set.

Plugged as Follows:

3343' to 3324' - Rock Plug
3324' to 3304' - Cement 10 Sx.
3304' to 3033' - Heavy Mud
Rep. 7" Pipe @ 3033'
3033 to 301' - Heavy Mud
301' to 295' - Rock Bridge
295' to 280' - Cement 19 Sx.
280' to 30' - Heavy Mud
30' to 10' - On Base of Cellar
15 Sx. Cement

2-18-42

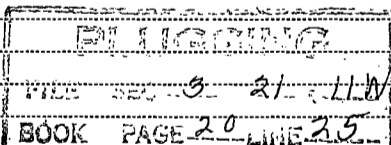

(If additional description is necessary, use BACK of this sheet)

Correspondence regarding this well should be addressed to R. C. Hauber
Address Cities Service Oil Company, Great Bend, Kansas

STATE OF Kansas COUNTY OF Barton, ss.
R. C. Hauber (employee of owner) or (owner or operator) of the above-described well,
being first duly sworn on oath, says: That I have knowledge of the facts, statements, and matters herein contained and the log of the above-described well as filed and that the same are true and correct. So help me God.

(Signature)

(Address)

SUBSCRIBED AND SWORN to before me this 17 day of February, 1942

My Commission Expires Sept. 26, 1942

My commission expires

Notary Public.



15.185.01475.0000



CITIES SERVICE OIL COMPANY

PRODUCERS-REFINERS-MARKETERS OF PETROLEUM PRODUCTS

**BARTLESVILLE
OKLAHOMA**

Great Bend, Kansas
February 17, 1942

State Corporation Commission
Conservation Division
800 Bitting Building
Wichita, Kansas

Gentlemen:

Attached herewith is Well Plugging Record
of the work done in connection with plugging and
abandoning our Sifers "A" well No. 1, Section 3-21-11W,
Stafford County, Kansas.

Yours very truly,

CITIES SERVICE OIL CO.

R. C. Hauber

EH:
Attach.

