

STATE OF KANSAS
STATE CORPORATION COMMISSION


Give All Information Completely
Make Required Affidavit
Mail or Deliver Report to:
Conservation Division
State Corporation Commission
212 North Market, Insurance Bldg.
Wichita, Kansas

WELL PLUGGING RECORD

Stafford County. Sec. 3 Twp. 21 Rge. (E) 11 (W)

Location as "NE/CNW $\frac{1}{4}$ SW $\frac{1}{4}$ " or footage from lines SE SE NE
Lease Owner Nadel and Gussman
Lease Name Synder Well No. A-1
Office Address 625 Union Center Building, Wichita, Kansas
Character of Well (completed as Oil, Gas or Dry Hole) Dry Hole
Date well completed February 28 19 61
Application for plugging filed February 28 19 61
Application for plugging approved February 28 19 61
Plugging commenced February 28 19 61
Plugging completed February 28 19 61
Reason for abandonment of well or producing formation

NORTH

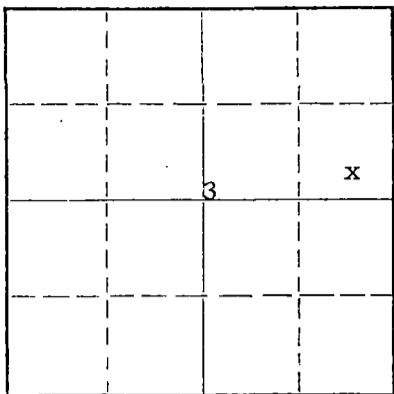

Locate well correctly on above Section Plat

If a producing well is abandoned, date of last production 19
Was permission obtained from the Conservation Division or its agents before plugging was commenced? Yes

Name of Conservation Agent who supervised plugging of this well Frank Broadfoot
Producing formation Depth to top Bottom Total Depth of Well Feet
Show depth and thickness of all water, oil and gas formations.

OIL, GAS OR WATER RECORDS

CASING RECORD

FORMATION	CONTENT	FROM	TO	SIZE	PUT IN	PULLED OUT

Describe in detail the manner in which the well was plugged, indicating where the mud fluid was placed and the method or methods used in introducing it into the hole. If cement or other plugs were used, state the character of same and depth placed, from feet to feet for each plug set.

Bottom plug set at 245 feet with 20 sacks of cement pumped through drill pipe
Top plug set at 35 feet with 10 sacks of cement pumped in surface pipe.

RECEIVED
STATE CORPORATION COMMISSION
3-21-61
MAR 21 1961
CONSERVATION DIVISION
Wichita, Kansas

(If additional description is necessary, use BACK of this sheet)
Name of Plugging Contractor Jones Drilling Company
Address Great Bend, Kansas

STATE OF Kansas, COUNTY OF Barton, ss.
A. M. Jones (employee of owner) or (owner or operator) of the above-described well, being first duly sworn on oath, says: That I have knowledge of the facts, statements, and matters herein contained and the log of the above-described well as filed and that the same are true and correct. So help me God.

(Signature) *A. M. Jones*
P. O. Box 106, Great Bend, Kansas
(Address)

SUBSCRIBED AND SWORN TO before me this 10th day of March, 19 61

My commission expires April 11, 1963
John W. Poos Notary Public.



WELL LOG

Date started 2-21-61
Date completed 2-28-61

Snyder #A-1
SE-SE-NE, Section 3, Twp. 21, Range 11W
Stafford County, Kansas

Set 8 5/8" surface pipe at 258' and
cemented with 225 sacks of cement.

Elevation	1759' KB
	1754' GL
Anhydrite	655'
Heebner shale	2918'
Brown lime	3047'
Lancing KC Lime	3065'
Arbuckle Dolomite	3365'
Total depth	3388' (-1629')

Bottom plug set at 245' with 20 sacks
of cement pumped through drill pipe and
top plug set at 35' with 10 sacks of cement
pumped in surface pipe.

- 0' - 70' Sand, shale and shells
- 70' - 220' Sand and shale
- 220' - 655' Red bed and shells
- 655' - 730' Anhydrite
- 730' - 1400' Shale and shells
- 1400' - 1950' Lime and shale
- 1950' - 2250' Shale and shells
- 2250' - 2925' Lime and shale
- 2925' - 3000' Shale and shells
- 3000' - 3150' Lime and shale
- 3150' - 3235' Lime
- 3235' - 3329' Lime and shale
- 3329' - 3355' Conglomerate
- 3355' - 3372' Shale and lime
- 3372' - 3388' Arbuckle

RECEIVED
 CONSERVATION DIVISION
 MARCH 1 1961
 CONSERVATION DIVISION
 Wichita, Kansas

Affidavit

State of Kansas County of Barton

I A. M. Jones, certify that the above is a true and correct log as reflected
by the daily drilling reports of the Jones Drilling Company.

By: A. M. Jones
A. M. Jones

Subscribed and sworn before me this 10th Day of March, 1961.

John W. Poos
 John W. Poos Notary Public

My Commission expires April 11, 1963.