


STATE OF KANSAS
STATE CORPORATION COMMISSION

WELL PLUGGING RECORD

Give All Information Completely
Make Required Affidavit
Mail or Deliver Report to:
Conservation Division
State Corporation Commission
212 No. Market
Wichita, Kansas

Rice County, Sec. 2 Twp. 21 Rge. 6 W (E) (W)
Location as "NE/CNW/SW" or footage from lines C N/2 NW NE

NORTH

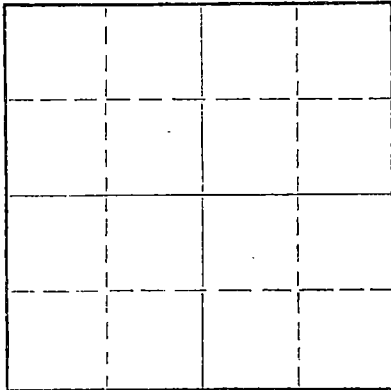

Locate well correctly on above
Section Plat

Lease Owner Pat SIMMONS
Lease Name Walsten Well No. D-1
Office Address 5252 North Broadway, Wichita, Kansas
Character of Well (completed as Oil, Gas or Dry Hole) oil
Date well completed 7-19 19 53
Application for plugging filed I-8 19 70
Application for plugging approved I-9 19 70
Plugging commenced I-12 19 70
Plugging completed I-14 19 70
Reason for abandonment of well or producing formation _____

If a producing well is abandoned, date of last production _____ 19 ____
Was permission obtained from the Conservation Division or its agents before plugging was commenced? Yes

Name of Conservation Agent who supervised plugging of this well Gilbert Toman
Producing formation _____ Depth to top _____ Bottom _____ Total Depth of Well 3408' Feet
Show depth and thickness of all water, oil and gas formations.

OIL, GAS OR WATER RECORDS

CASING RECORD

FORMATION	CONTENT	FROM	TO	SIZE	PUT IN	PULLED OUT
				5 1/2"		2,533'

Describe in detail the manner in which the well was plugged, indicating where the mud fluid was placed and the method or methods used in introducing it into the hole. If cement or other plugs were used, state the character of same and depth placed, from _____ feet to _____ feet for each plug set.

Plugged off bottom of hole with sand. Sand from 3408' to 3380'. Dumped 5 ax of cement. Mudded hole to 260'. Made 10' of rock bridge. Dumped 9 Yrds. of Ready-Mix cement, filling to the botton of the collar.

RECEIVED
STATE CORPORATION COMMISSION
JAN 23 1970
CONSERVATION DIVISION
Wichita, Kansas

(If additional description is necessary, use BACK of this sheet)
Name of Plugging Contractor Art Lamb Casing Pulling Co.
Address 2809 King St. Hutchinson, Kansas 67501

STATE OF Kansas, COUNTY OF Reno, ss.
Art Lamb (employee of owner) or (owner or operator) of the above-described well, being first duly sworn on oath, says: That I have knowledge of the facts, statements, and matters herein contained and the log of the above-described well as filed and that the same are true and correct. So help me God.

(Signature) [Signature]
2809 King St. Hutchinson, Kansas 67501
(Address)

SUBSCRIBED AND SWORN to before me this 15th day of January, 19 70

My commission expires January 5, 1970

[Signature]
Notary Public.

WELL LOG BUREAU—KANSAS GEOLOGICAL SOCIETY
508 East Murdock, Wichita, Kansas


Company- H. C. BENNETT
Farm- Walsten "D" No. 1

SEC. 2 T. 21 R. 6W
C N/2 NW NE

Total Depth. 3408
Comm. 7-1-53 Comp. 7-19-53
Sh. treated.
Contractor. Mallard Drilling Co.
No. 9-18-54

County Rice

KANSAS

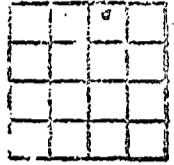

Elevation. 1575 FB

Production. 16 BC, 25 BW

CASING:

137' w/ 100 sx cmt.
2 @ 3393'

Figures indicate bottom of Formations.

Shale	700
lime & shale	1240
sandy lime	1400
lime & shale	2660
sand, shale & lime	2775
sandy shale	2857
lime & shale	2885
lime	3025
lime & shale	3120
lime	3200
lime & shale	3391
Mississippi lime	3408
Total Depth	
TOPS:	
Mississippi	3391
1st SO	3395
more oil, some water	3407

RECEIVED
STATE CORPORATION COMMISSION
JAN 9 1970
CONSERVATION DIVISION
Wichita, Kansas