


STATE OF KANSAS
STATE CORPORATION COMMISSION


Give All Information Completely
Make Required Affidavit
Mail or Deliver Report to:
Conservation Division
State Corporation Commission,
800 Bittling Building,
Wichita, Kansas

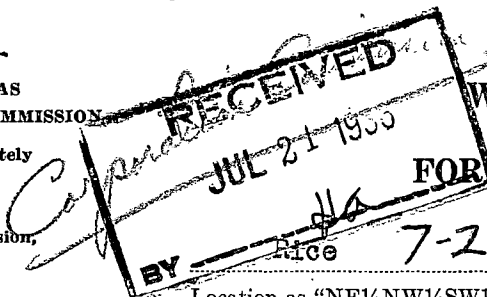

WELL PLUGGING RECORD
OR
FORMATION PLUGGING RECORD

Strike out upper line
when reporting plug-
ging off formations.

NORTH

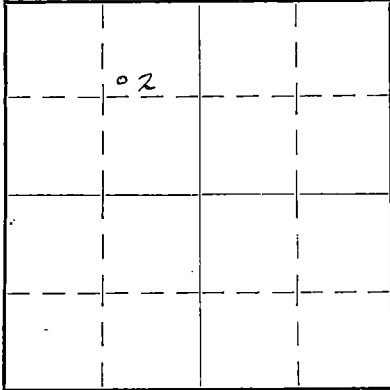

Locate well correctly on above
Section Plat

Name of Conservation Agent who supervised plugging of this well. Raymond Gear
Producing formation. Miss. Chat Depth to top. 3362 Bottom 3488 Total Depth of Well 3488 Feet
Show depth and thickness of all water, oil and gas formations.


OIL, GAS OR WATER RECORDS

CASING RECORD

Formation	Content	From	To	Size	Put In	Pulled Out
Chat	Dry	3362	80	15 1/2	170	58'
"	Oil & Gas	3380	82	12 1/8	825	542
				8 1/2	2310	2310
				6-5/8	3010	3010
				5-3/16	3391	3391
				10"	1657'	1657'

Describe in detail the manner in which the well was plugged, indicating where the mud fluid was placed and the method or methods used in introducing it into the hole. If cement or other plugs were used, state the character of same and depth placed, from _____ feet to _____ feet for each plug set.

Plugged from old total depth to 3367' with 7 sacks cement.
Pulled casing as shown. Mudded hole to surface and cemented surface
with 15 sacks.

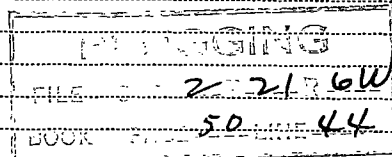

(If additional description is necessary use BACK of this sheet)

Correspondence regarding this well should be addressed to Phillips Petroleum Company
Address Ellis Singleton Building, Wichita, Kansas

STATE OF Kansas, COUNTY OF Sedgwick, ss.

_____, (employee of owner) or (owner or operator) of the above-described well,
being first duly sworn on oath, says: That I have knowledge of the facts, statements, and matters herein contained and the log of the above-
described well as filed and that the same are true and correct. So help me God.

(Signature) J. Hamilton

Great Bend, Kansas
(Address)

SUBSCRIBED AND SWORN to before me this 16th day of July, 19 36.

My commission expires April 27, 1940 M. A. Miles
Notary Public.

INDEPENDENT OIL AND GAS COMPANY

COMPANY *Independent Oil & Gas Co.* COUNTY *Rice* STATE *Kansas*FARM NAME *Walsten* WELL NO. *2*LOCATION *Gen. SW NE NW* SEC. *2* TWP. *21* RANGE *6W*INITIAL PRODUCTION—NATURAL *1000* SHOT

DRILLING COMMENCED

DRILLING COMPLETED

TOTAL DEPTH *3466*

ELEVATION

CASING RECORD

FORMATION RECORD

SIZE	FEET
15 1/2"	170'
12 1/2"	825
8"	2345
6 5/8	2963
5 3/16	3362

FORMATION

FROM

TO

Red Rock	0	120
Slate, light	120	140
Red Rock	140	170
Lime	170	175
Red Rock	175	200
Red Rock	200	300
Slate, light	300	515
Salt	515	825
Lime	825	827
Sh. & Lime Shells	827	980
Lime	980	1020
Shale	1020	1030
Red Rock	1030	1038
Lime	1038	1040
Sandy Shale	1040	1070
Lime	1070	1080
Slate	1080	1100
Red Rock	1100	1110
Slate	1110	1120
Lime	1120	1250
Shale	1250	1260
Red Rock	1260	1270
Lime	1270	1275
Shale	1275	1300
Lime	1300	1330
Slate	1330	1340
Lime	1340	1390
Shale	1390	1405
Red Rock	1405	1407
Lime	1407	1413
Shale	1413	1420
Lime	1420	1425

10 B. W.

1 1/2 B. W. 1230

2 B. W.

PLUGGING

Shale	FILE SEC 2 T 21 R 6 W	1425	1435
Red Rock	BOOK PAGE 50 LINE 44	1435	1445
Shale		1445	1465
Lime		1465	1470
Shale		1470	1480
Sandy Lime		1480	1525
Red Rock		1525	1535
Lime		1535	1570
Shale		1570	1630
Sandy Lime	4 B. water	1630	1650
Lime		1650	1665
Shale		1665	1870
Red Rock		1870	1885
Shale		1885	1940
Lime		1940	1950
Shale		1950	2085
Red Rock		2085	2090
Shale		2090	2185
Lime		2185	2195
Shale		2195	2235
Lime	10 B. W 2280	2235	2345
Lime		2345	2585
Slate		2585	2610
Lime	HFV	2610	2615
Slate		2615	2625
Sand		2625	2725
Slate		2725	2800
Lime		2800	2810
Slate		2810	2825
Lime		2825	2910
Sandy Lime	6 B W 2915-	2910	2925

FORMATION

FROM

TO

Lime	2925	2950
Sand	2950	2965
Lime	2965	3150
Slate	3150	3160
Lime	3160	3230
Shale, dark	3230	3245
Red Rock	3245	3250
Lime	3250	3255
Shale	3255	3350
Red Rock	3350	3362
Chat	3362	3362

HPW

Oil & Gas Show

Flowed at 3362-Sand

Bottom Hole 3466 Steel Line Measurement

Sand	3362	3466
------	------	------

Total Depth	3466
-------------	------