


STATE OF KANSAS  
STATE CORPORATION COMMISSION

Form CP-4

WELL-PLUGGING RECORD

Give All Information Completely  
Make Required Affidavit  
Mail or Deliver Report to:  
Conservation Division  
State Corporation Commission  
212 No. Market  
Wichita, Kansas 67202

NORTH

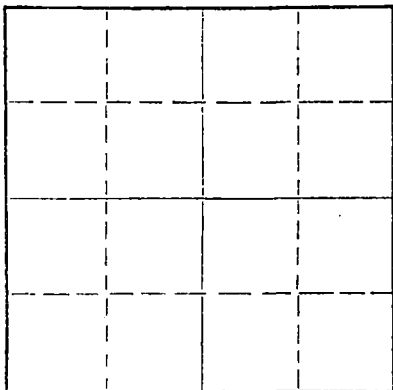

Locate well correctly on above  
Section Plat

Rice County, Sec. 2 Twp. 21 Rge. 6 W (E) (W)  
Location as "NE/CNW&SW&W" or footage from lines NW C SW  
Lease Owner Northridge Oil Co.  
Lease Name Duvall Well No. 4  
Office Address Bx 18271 Denver, Colorado  
Character of Well (completed as Oil, Gas or Dry Hole) oil  
Date well completed 11-10-71  
Application for plugging filed 12-7-71  
Application for plugging approved 12-8-71  
Plugging commenced 12-8-71  
Plugging completed 12-14-71  
Reason for abandonment of well or producing formation \_\_\_\_\_

If a producing well is abandoned, date of last production \_\_\_\_\_ 19\_\_\_\_  
Was permission obtained from the Conservation Division or its agents before plugging was commenced? Yes

Name of Conservation Agent who supervised plugging of this well Gilbert Toman  
Producing formation \_\_\_\_\_ Depth to top \_\_\_\_\_ Bottom \_\_\_\_\_ Total Depth of Well 3376' Feet  
Show depth and thickness of all water, oil and gas formations.

OIL, GAS OR WATER RECORDS

CASING RECORD

FORMATION	CONTENT	FROM	TO	SIZE	PUT IN	PULLED OUT
				7"		1,800'

Describe in detail the manner in which the well was plugged, indicating where the mud fluid was placed and the method or methods used in introducing it into the hole. If cement or other plugs were used, state the character of same and depth placed, from \_\_\_\_\_ feet to \_\_\_\_\_ feet for each plug set.

Plugged off bottom of hole with sand. Sand from 3376' to 3360'. Dumped 6 sx of cement. Mudded hole to 210'. Made 10' of rock bridge. Dumped 50 sx of cement. Mudded hole to 40'. Made 10' of rock bridge. Dumped 15 sx of cement, filling to the bottom of the cellar.

RECEIVED  
STATE CORPORATION COMMISSION  
DEC 20 1971  
CONSERVATION DIVISION  
Wichita, Kansas

(If additional description is necessary, use BACK of this sheet)

Name of Plugging Contractor Art Lamb Casing Pulling Co.  
Address 2809 King St. Hutchinson, Kansas 67501

STATE OF Kansas, COUNTY OF Reno, ss.  
Art Lamb (employee of owner) or (owner or operator) of the above-described well, being first duly sworn on oath, says: That I have knowledge of the facts, statements, and matters herein contained and the log of the above-described well as filed and that the same are true and correct. So help me God.

(Signature) [Signature]  
2809 King St. Hutchinson, Kansas 67501  
(Address)

SUBSCRIBED AND SWORN TO before me this 14th day of December, 1971

My commission expires January 5, 1974  
[Signature] Notary Public.


15.159.19390.0000

WELL LOG BUREAU -- KANSAS GEOLOGICAL SOCIETY  
412 Union National Bk. Bldg., Wichita, Kansas

Company - H. C. BENNETT  
Farm - Duvall No. 7

SEC. 2 T. 21 R. 6W  
NWc SW

Total Depth. 3376'  
Comm 10-26-46 Comp. 11-10-46  
Shot or Treated.  
Contractor. Rotary 0-3358'  
Issued. 3-22-47 Cable 3358+3376'

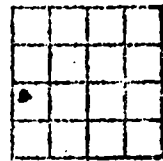County. Rice  
KANSAS  


CASING:  
10 3/4" 161' Com.w/125 sx.  
7" 3325' Com.w/35 sx.

Elevation. \_\_\_\_\_  
Production. 66 B.

Figures Indicate Bottom of Formations.

shale & shells	0-120
shale	485
shale & salt	945
lime & shale	1290
lime brkn	1380
shale & lime	1640
shale & shells	1780
lime & shale	2025
shale & shells	2130
lime & shale	2230
lime	2545
lime & shale	2600
shale & shells	2720
lime	3175
lime & shale	3280
shale & lime	3352
conglomerate	3355
chat	3358
Rotary T.D.	
Chat	3376
Cable Total Depth	
Tops:	
Chat	3355

RECEIVED  
STATE CORPORATION COMMISSION  
DEC 8 1971  
CONSERVATION DIVISION  
Wichita, Kansas