


STATE OF KANSAS
STATE CORPORATION COMMISSION

Form CP-4

Give All Information Completely
Make Required Affidavit
Mail or Deliver Report to:
Conservation Division
State Corporation Commission
212 No. Market
Wichita, Kansas

WELL PLUGGING RECORD

NORTH

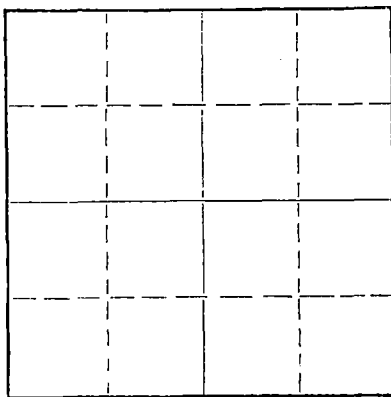

Locate well correctly on above
Section Plat

Rice County. Sec. 2 Twp. 21 Rge. 6 (E) (W)
Location as "NE/CNW/SW" or footage from lines SW-NW-SW
Lease Owner Commercial Oil Co.
Lease Name Duvall Well No. 1
Office Address 5252 N. Broadway Wichita, Kansas
Character of Well (completed as Oil, Gas or Dry Hole) oil
Date well completed _____ 19____
Application for plugging filed _____ 8-25- 1970
Application for plugging approved _____ 8-25- 1970
Plugging commenced _____ 9-4- 1970
Plugging completed _____ 9-8- 1970
Reason for abandonment of well or producing formation _____

If a producing well is abandoned, date of last production _____ 19____
Was permission obtained from the Conservation Division or its agents before plugging was commenced? yes

Name of Conservation Agent who supervised plugging of this well Gilbert Toman
Producing formation _____ Depth to top _____ Bottom _____ Total Depth of Well 3398 Feet
Show depth and thickness of all water, oil and gas formations.

OIL, GAS OR WATER RECORDS

CASING RECORD

FORMATION	CONTENT	FROM	TO	SIZE	PUT IN	PULLED OUT
				7"	3385	1400
				10 3/4"	140	none

Describe in detail the manner in which the well was plugged, indicating where the mud fluid was placed and the method or methods used in introducing it into the hole. If cement or other plugs were used, state the character of same and depth placed, from _____ feet to _____ feet for each plug set.

Sand from 3398 to 3375 - dump 6 sack cement - pull 1400 ft. 7".
Rock bridge from 215 to 200 ft. - dump 4 1/2 yds ready mix cement to surface.

RECEIVED
STATE CORPORATION COMMISSION

OCT 7 1970

CONSERVATION DIVISION
Wichita, Kansas

(If additional description is necessary, use BACK of this sheet)

Name of Plugging Contractor Ralph Comstock Pipe Pulling, Inc. Permit # 490
Address Stafford, Kansas

STATE OF Kansas, COUNTY OF Stafford, ss.
Ralph Comstock (employee of owner) or (owner or operator) of the above-described

well, being first duly sworn on oath, says: That I have knowledge of the facts, statements, and matters herein contained and the log of the above-described well as filed and that the same are true and correct. So help me God?

(Signature)

Ralph Comstock
Stafford, Kas.
(Address)

SUBSCRIBED AND SWORN TO before me this 7 day of Oct, 1970

My commission expires

Nov 30th 1970

Notary Public.

15.159.05207.0000

COPY


WELL LOG BUREAU KANSAS GEOLOGICAL SOCIETY
412 Union National Bk. Bldg., Wichita, Kansas

Company - H. C. BENNETT
Farm - Duval No. 1

SEC. 2 T. 21 R. 6 W
SW NW SW

Total Depth. 3398'
Comm. 9-20-46 Comp. 10-9-45
Shot or Treated:
Contractor:
Issued. 2-9-46

County. Rice
KANSAS

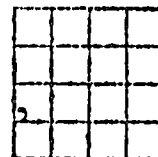

CASING:

10 3/4" 140' Cem.
7" 3366' Cem.

Elevation. _____

Production. Pot. 75 B.

Figures Indicate Bottom of Formations.

sand & clay	70
shale & shells	143
red rock, shale, shells	260
shale, shells	525
salt	780
shale, shells	1205
sand, sand rock	1250
lime sdy, shale	1340
lime & shale	1540
lime, shells	1600
lime, shale	1805
shale, shells	1915
lime, shale	2395
lime	2550
lime, shale	2620
lime brkn	2690
lime, shale	2835
lime	2875
lime, shale	2950
lime	2975
lime, shale	3015
lime	3107
shale & lime	3318
lime	3398
Total Depth.	

RECEIVED
STATE CORPORATION COMMISSION
AUG 25 1970
CONSERVATION DIVISION
Wichita, Kansas