


Give All Information Completely
Make Required Affidavit
Mail or Deliver Report to:
Conservation Division
State Corporation Commission
211 No. Broadway
Wichita, Kansas

WELL PLUGGING RECORD

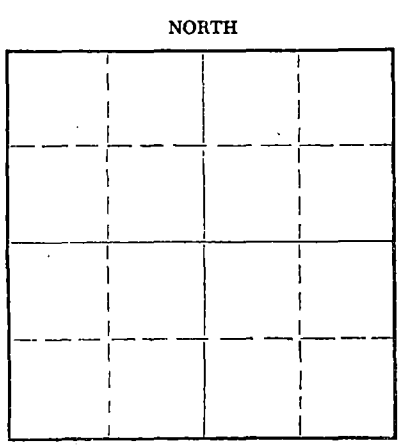

Rice County. Sec. 2 Twp. 21 Rge. 6 (E) W (W)
Location as "NE/CNW/SW" or footage from lines. SE NE NE
Lease Owner Sterling Drilling Company
Lease Name White "C" Well No. 2
Office Address Sterling, Kansas
Character of Well (completed as Oil, Gas or Dry Hole) _____
Date well completed _____ 19____
Application for plugging filed _____ 19____
Application for plugging approved _____ 19____
Plugging commenced 12-20-63 _____ 19____
Plugging completed 12-24-63 _____ 19____
Reason for abandonment of well or producing formation Depleted.
If a producing well is abandoned, date of last production _____ 19____
Was permission obtained from the Conservation Division or its agents before plugging was commenced? yes

Name of Conservation Agent who supervised plugging of this well Gilbert Toman
Producing formation _____ Depth to top _____ Bottom _____ Total Depth of Well 3417 Feet
Show depth and thickness of all water, oil and gas formations.

OIL, GAS OR WATER RECORDS

CASING RECORD

FORMATION	CONTENT	FROM	TO	SIZE	PUT IN	PULLED OUT
				8-5/8"	120'	None
				5-1/2"	3381'	3030'

Describe in detail the manner in which the well was plugged, indicating where the mud fluid was placed and the method or methods used in introducing it into the hole. If cement or other plugs were used, state the character of same and depth placed, from _____ feet to _____ feet for each plug set.

Checked hole, sanded hole and dumped 5 sacks of cement with dump bailer. Pulled 5 1/2" casing, mudded hole from 420' to 150', set rock bridge and dumped 25 sacks of cement. Mudded hole to 30', and ran 10 sacks of cement to base of cellar.

PLUGGING COMPLETE.

RECEIVED
STATE CORPORATION COMMISSION

1-10-64 JAN 10 1964

CONSERVATION DIVISION
Wichita, Kansas

(If additional description is necessary, use BACK of this sheet)
Name of Plugging Contractor KNIGHT CASING PULLING COMPANY
Address CHASE, KANSAS

STATE OF KANSAS COUNTY OF RICE, ss.
Noel J. Knight (employee of owner) or (owner or operator) of the above-described well, being first duly sworn on oath, says: That I have knowledge of the facts, statements, and matters herein contained and the log of the above-described well as filed and that the same are true and correct. So help me God.

(Signature) Noel J. Knight
Chase, Kansas
(Address)

SUBSCRIBED AND SWORN TO before me this 3rd day of January, 1964

Milton J. Volin
Notary Public.

My commission expires May 20, 1964

WELL LOG ----- WHITE "C"-#2

Location: SE NE NE, Sec. 2-21-6
Rice County, Kansas

OWNER: Davis - Child
ROTARY DRILLING CONTRACTOR: Group Exploration Company
CABLE TOOL CONTRACTOR:

RECEIVED
STATE CORPORATION COMMISSION

DEC 19 1963

CONSERVATION DIVISION
Wichita, Kansas

COMMENCED: April 22-54 (w.r.)
(w.c.t.)

COMPLETED: May 1-54 (w.r.)
(w.c.t.)

TOTAL DEPTH: 3382'

LOG

0-30	Sand
30-120	Red Bed
120-320	Red Bed & Shale
320-820	Shale, Salt & Shells
820-1015	Lime & Shale
1015-1200	Lime
1200-1380	Lime & Shale
1380-1515	Lime
1515-2000	Shale
2000-2195	Shale & Shells
2195-2345	Shale
2345-2550	Lime
2550-2740	Shale
2740-3160	Lime
3160-3230	Lime & Shale
3230-3360	Lime
3360-3382	Cong. & Chat
3382	T.D.

CASING RECORD

Ran 120' of 8-5/8"
Casing cemented with 100
sacks of cement.

Ran 3381' of 5-1/2"
Casing, cemented with 50
sacks of cement.