

Give All Information Completely
Make Required Affidavit
Mail or Deliver Report to:
Conservation Division
State Corporation Commission
212 No. Market
Wichita, Kansas

WELL PLUGGING RECORD

Stafford County. Sec. 5 Twp. 21 Rge. (E) 11(W)

Location as "NE/CNW/SW" or footage from lines S/2 SE NE

Lease Owner F. G. Holl

Lease Name Meyers Well No. 2

Office Address 6427 East Kellogg, Wichita, Kansas

Character of Well (completed as Oil, Gas or Dry Hole) oil

Date well completed 19

Application for plugging filed April 24 1970

Application for plugging approved 19


Plugging commenced May 2 1970

Plugging completed May 5 1970

Reason for abandonment of well or producing formation depleted

If a producing well is abandoned, date of last production 19

Was permission obtained from the Conservation Division or its agents before plugging was commenced? yes

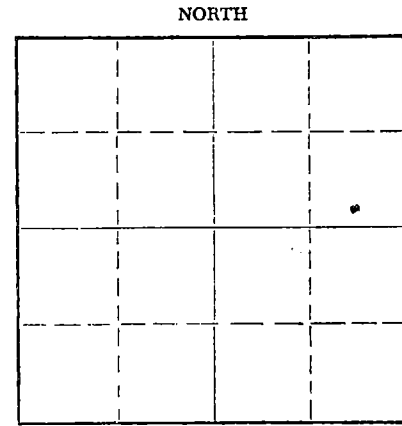

Locate well correctly on above Section Plat

Name of Conservation Agent who supervised plugging of this well G. R. Biberstein

Producing formation Depth to top Bottom Total Depth of Well 3425 Feet

Show depth and thickness of all water, oil and gas formations.

OIL, GAS OR WATER RECORDS

CASING RECORD

FORMATION	CONTENT	FROM	TO	SIZE	PUT IN	PULLED OUT
		0	257'	8 5/8"	257'	none
		0	3401'	4 1/2"	3401'	2839.35

Describe in detail the manner in which the well was plugged, indicating where the mud fluid was placed and the method or methods used in introducing it into the hole. If cement or other plugs were used, state the character of same and depth placed, from feet to feet for each plug set.

Sanded back to 3390' and dumped 1/2 sacks of cement.

Squeezed well with 15 sacks of mud and 90 sacks of cement.

RECEIVED
STATE CORPORATION COMMISSION
MAY 13 1970
CONSERVATION DIVISION
Wichita, Kansas

(If additional description is necessary, use BACK of this sheet)

Name of Plugging Contractor PIPE PULLERS, INC.
Address Box 486, Ellinwood, Kansas

STATE OF Kansas, COUNTY OF Barton, ss.

Evelyn Roth (employee of owner) or (owner or operator) of the above-described well, being first duly sworn on oath, says: That I have knowledge of the facts, statements, and matters herein contained and the log of the above-described well as filed and that the same are true and correct. So help me God.

(Signature) Evelyn Roth
Ellinwood, Kansas

(Address)

SUBSCRIBED AND SWORN to before me this 11th day of May, 1970

George A. Meyer
Notary Public.

My commission expires Feb. 10, 1971

W E L L L O G

Date Commenced: December 3, 1966
 Date Completed: December 11, 1966

F. G. Holl
 MEYERS #2
 S/2 SE/4 NE/4
 Sec. 5-21s-11w
 Stafford County, Kansas

0 - 30' Surface Sand & Clay
 30 - 210' Sand & Shale
 210 - 547' Red Bed
 547 - 575' ANHYDRITE
 575 - 1160' Shale & Shells
 1160 - 1370' Salt & Shale
 1370 - 1615' Shale & Shells
 1615 - 1960' Shale & Lime
 1960 - 2650' Shale & Shells
 2650 - 3001' Lime
 3001 - 3005' Shale
 3005 - 3030' Lime Shale
 3030 - 3122' Shale
 3122 - 3144' Lime & Shale
 3144 - 3400' Lime
 3400 - 3425' Dolomite
 3425 RTD

ELEVATION: 1798 K.B.

FORMATION DATA

Anhydrite	547
Heebner	3001
Brown Lime	3122
Lansing	3144
Arbuckle	3400
RTD	3425

SURFACE CASING: Set 8-5/8" pipe at 257' with 225 sacks cement.


PRODUCTION CASING: Set 4 1/2" casing at 3401' with 600 gals latex cement.

RECEIVED
 STATE CORPORATION COMMISSION
 APR 27 1970
 CONSERVATION DIVISION
 Wichita, Kansas

AFFIDAVIT

STATE OF KANSAS
 COUNTY OF BARTON) ss.

L. O. Chubb of lawful age does swear that the fact and statements herein contained are true and correct to the best of his knowledge.

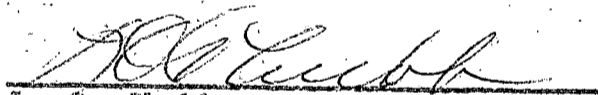
 L. O. Chubb

Subscribed and sworn to before me this 22 day of December, 1966.

My Comm. Expires:
April 11, 1970


 Dorothy M. Hague-NOTARY PUBLIC