


STATE OF KANSAS
STATE CORPORATION COMMISSION

WELL PLUGGING RECORD

Give All Information Completely
Make Required Affidavit
Mail or Deliver Report to:
Conservation Division
State Corporation Commission
800 Bittling Building
Wichita, Kansas

Stafford County. Sec. 5 Twp. 21 Rge. 11 (E) W (W)
Location as "NE/CNW/SW" or footage from lines SW SW SW
Lease Owner Frank G. Wood Drilling Company
Lease Name Kasselman 'B' Well No. 1
Office Address Box 619, Great Bend, Kansas
Character of Well (completed as Oil, Gas or Dry Hole) Oil
Date well completed January 19 19 55
Application for plugging filed June 21 19 55
Application for plugging approved June 22 19 55
Plugging commenced July 13 19 55
Plugging completed July 13 19 55
Reason for abandonment of well or producing formation dry

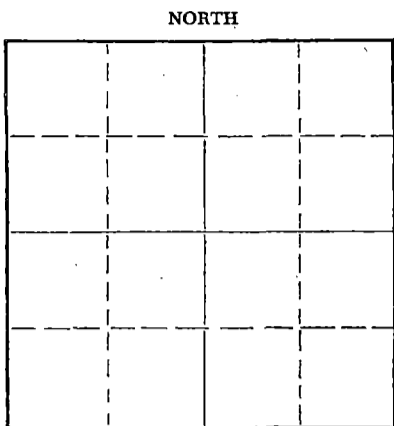

Locate well correctly on above
Section Plat

If a producing well is abandoned, date of last production May 28 19 55
Was permission obtained from the Conservation Division or its agents before plugging was commenced? Yes

Name of Conservation Agent who supervised plugging of this well M. A. Rives
Producing formation Lansing Depth to top 3214 Bottom 3219 Total Depth of Well 3480 Feet
Show depth and thickness of all water, oil and gas formations.

OIL, GAS OR WATER RECORDS

CASING RECORD

FORMATION	CONTENT	FROM	TO	SIZE	PUT IN	PULLED OUT
				8 5/8"	235'	None
				5 1/2"	3441'	2839.25'

Describe in detail the manner in which the well was plugged, indicating where the mud fluid was placed and the method or methods used in introducing it into the hole. If cement or other plugs were used, state the character of same and depth placed, from _____ feet to _____ feet for each plug set.

Plug back with sand to 3200', dump 5 sacks cement, pull
5 1/2" casing. Mud hole to 230', set 5 ft. rock bridge,
mix and dump 20 sacks cement. Mud hole to 35' of base
of cellar, set 5' rock bridge, mix and put in 10 sacks
cement, filled to base of cellar.

7-22-55
RECEIVED
STATE CORPORATION COMMISSION
JUL 22 1955
WICHITA, KANSAS

(If additional description is necessary, use BACK of this sheet)

Name of Plugging Contractor Ace Pipe Pulling Company
Address Box 304, Great Bend, Kansas

STATE OF Kansas, COUNTY OF Barton, ss.
Frank G. Wood (employee of owner) or (owner or operator) of the above-described well, being first duly sworn on oath, says: That I have knowledge of the facts, statements, and matters herein contained and the log of the above-described well as filed and that the same are true and correct. So help me God.

(Signature) Frank G. Wood
Great Bend, Kansas
(Address)

SUBSCRIBED AND SWORN TO before me this 19th day of July 19 55

Dean E. Cooley
Notary Public.

My commission expires April 29, 1957

PLUGGING
FILE SEC 5 T21 R 11 W
BOOK PAGE 128 LINE 25

WELL LOG
Kasselman B-1
SW SW SW of 5-21-11W
Stafford County, Kansas

Commenced: 12-23-54
Completed: 1-8-55

Elevation 1804 KB
Anhydrite 573 (-1231)
Heebner 2996 (-1192)
Bra. Lime 3120 (-1316)
Lansing 3137 (-1333)
Simpson Sand 3394 (-1590)
Arbuckle 3439 (-1635)

0-210	Sand
210-235	Red clay
235-635	Red bed
635-1150	Shale and shells
1150-1275	Salt and shale
1275-1495	Shale and shells
1495-1786	Shale, shells & lime streaks
1786-1940	Broken lime
1940-2755	Lime and shale
2755-2990	Lime
2990-3155	Lime
3155-3255	Lime
3255-3405	Lime
3405-3430	Simpson shale
3430-3439	Shale
3439-3444	Arbuckle

ROTARY TOTAL DEPTH

A F F I D A V I T

STATE OF Kansas, COUNTY OF Barton, SS

I, Lynn O. Duke, of the DUKE & WOOD DRILLING COMPANY,
being first duly sworn on oath, state; That I have knowledge of the facts,
statements and matters herein contained and that the same are true and correct.

Lynn O. Duke
Partner

Subscribed and sworn to before me this 10th day of February, 1955.

Dennis Dooley
Notary Public

My commission expires: April 29, 1957.

PLUGGING
PER SEC 5 121 R 11W
BOOK PAGE 128 LINE 25

STATE BOARD OF CONSERVATION
JUN 22 1955
CONSERVATION DIVISION
Wichita, Kansas