

STATE OF KANSAS
STATE CORPORATION COMMISSION

WELL PLUGGING RECORD

Give All Information Completely
Make Required Affidavit
Mail or Deliver Report to:
Conservation Division
State Corporation Commission
800 Bittling Building
Wichita, Kansas

OR

Strike out upper line
when reporting plugging
off formations.

FORMATION PLUGGING RECORD

Rice County. Sec. 10 Twp. 21 Rge. 7W (E)E/2(W) NW

Location as "NE1/4NW1/4SW1/4" or footage from lines E/2 NW 10-21-7W

Lease Owner Simon Lebow

Lease Name Van Blarcom Well No. #1

Office Address 807 Palace Bldg, Tulsa, Oklahoma

Character of Well (completed as Oil, Gas or Dry Hole) Oil

Date well completed 3-28-38 19

Application for plugging filed October 1, 1947 19

Application for plugging approved October 1, 1947 19


Plugging commenced November 21, 1947 19

Plugging completed November 26, 1947 19

Reason for abandonment of well or producing formation Non-Producing

If a producing well is abandoned, date of last production 19

Was permission obtained from the Conservation Division or its agents before plugging was commenced? Yes

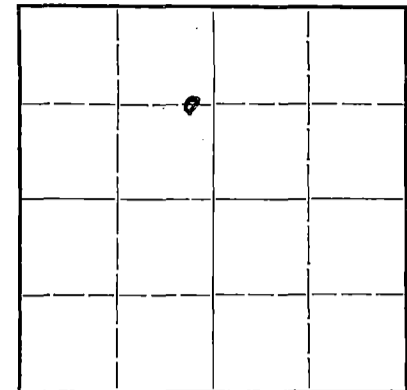

Locate well correctly on above
Section Plat

Name of Conservation Agent who supervised plugging of this well Ruell Durkee

Producing formation Chat Depth to top 3380 Bottom 3382 Total Depth of Well 3382 Feet

Show depth and thickness of all water, oil and gas formations.


OIL, GAS OR WATER RECORDS

CASING RECORD

Formation	Content	From	To	Size	Put In	Pulled Out
Chat						

Describe in detail the manner in which the well was plugged, indicating where the mud fluid was placed and the method or methods used in introducing it into the hole. If cement or other plugs were used, state the character of same and depth placed, from feet to feet for each plug set.

Dumped 6 sacks of cement at 3364'. Shot pipe at 2700', 2600' and at 2550'. Pulled pipe and mudded hole to 150'. Dumped 20 sacks of cement at 150' and put 5 sacks of cement at top of surface pipe.

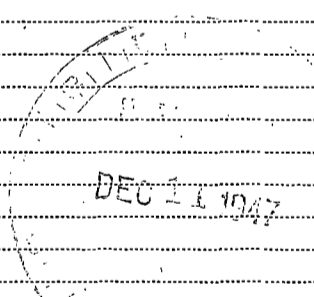

(If additional description is necessary, use BACK of this sheet)

Correspondence regarding this well should be addressed to Simon Lebow, 807 Palace Bldg. Tulsa, Okla.

Address

STATE OF Oklahoma, COUNTY OF Tulsa, ss.

Simon Lebow (employee of owner) or (owner or operator) of the above-described well,

being first duly sworn on oath, says: That I have knowledge of the facts, statements, and matters herein contained and the log of the above-described well as filed and that the same are true and correct. So help me God.

(Signature) *Simon Lebow*

(Address)

SUBSCRIBED AND SWORN TO before me this 9th day of December, 19 47

H. Landers

Notary Public.

My commission expires May, 19, 1948

