

STATE OF KANSAS  
STATE CORPORATION COMMISSION

WELL PLUGGING RECORD


OR

FORMATION PLUGGING RECORD

Strike out upper line  
when reporting plug-  
ging off formations.

Give All Information Completely  
Make Required Affidavit  
Mail or Deliver Report to:  
Conservation Division  
State Corporation Commission  
800 Bitting Building  
Wichita, Kansas

Rice County, Sec. 10, Twp. 21, Rge. (E) 7A (W)  
Location as "NE 1/4 NW 1/4 SW 1/4" or footage from lines 1320' W of E & 330' N of S line of SW 1/4

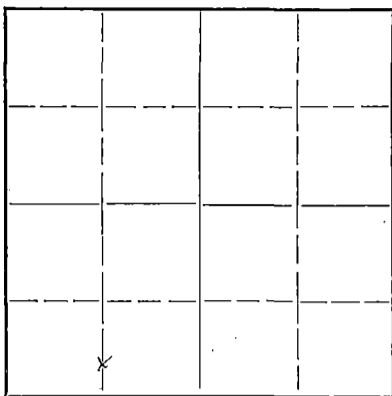

Locate well correctly on above  
Section Plat

Lease Owner Darby Petroleum Corporation  
Lease Name Johnson Well No. 3  
Office Address 1015 Philtower, Tulsa, Okla.  
Character of Well (completed as Oil, Gas or Dry Hole) Oil.  
Date well completed June 19, 1936 19  
Application for plugging filed July 29, 1942 19  
Application for plugging approved July 31, 1942 19  
Plugging commenced Sept. 15, 1942 19  
Plugging completed Sept. 20, 1942 19  
Reason for abandonment of well or producing formation Ceased producing.

If a producing well is abandoned, date of last production March 1, 1942 19  
Was permission obtained from the Conservation Division or its agents before plugging was com-  
menced? Yes.

Name of Conservation Agent who supervised plugging of this well Durkee, McPherson, Kansas.  
Producing formation Chat Depth to top 3372 Bottom 3383 Total Depth of Well 3383 Feet  
Show depth and thickness of all water, oil and gas formations.

OIL, GAS OR WATER RECORDS


CASING RECORD

Formation	Content	From	To	Size	Put In	Pulled Out
Chat	Oil	3372	3383	15 1/2" 7"OD	95' 8" 3372'	None 2252' 6"

Describe in detail the manner in which the well was plugged, indicating where the mud fluid was placed and the method or methods used in introducing it into the hold. If cement or other plugs were used, state the character of same and depth placed, from.....feet to.....feet for each plug set.

3389 - 3350' Mud  
3350 - 3330' Cement - 6 sacks  
3330' - 175' Mud  
175 - 155' Cement - 25 sacks  
155 - 8' Mud  
8' to Base of Celler - Cement - 10 sacks.

10-21-7W  
44 LINE 40

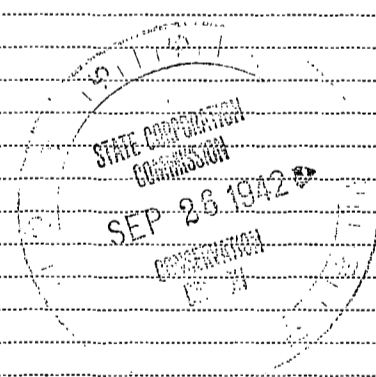

(If additional description is necessary, use BACK of this sheet)

Correspondence regarding this well should be addressed to Darby Petroleum Corporation,  
Address 1015 Philtower, Tulsa, Okla.

STATE OF Oklahoma, COUNTY OF Tulsa, ss.  
W. H. Barclay (employee of owner) of the above-described well,

being first duly sworn on oath, says: That I have knowledge of the facts, statements, and matters herein contained and the log of the above-described well as filed and that the same are true and correct. So help me God.

(Signature) W. H. Barclay  
1015 Philtower, Tulsa, Oklahoma (Address)

SUBSCRIBED AND SWORN to before me this 25th day of September 1942.

J. E. Wailes  
Notary Public.

My commission expires March 1, 1946.



FORMATION RECORD

	<u>FROM</u>	<u>TO</u>
Surface	0	106
Shale & shells	106	1000
Lime	1000	1060
Shale & shells	1060	1231
Lime	1231	1400
Shale & shells	1400	1896
Shale	1896	2280
Shale & Shells	2280	2440
Lime	2440	2595
Shale & shells	2595	2800
Lime	2800	2900
Shale & shells	2900	3215
Shale	3215	3270
Shale & shells	3270	3340
Blue shale	3340	3344
Variegated shale	3344	3347
do very sandy	3347	3351
Lime	3351	3352
Conglomerate	3352	3354
Red shale	3354	3355
Conglomerate	3355	3361
Red & green cemented sand	3361	3364
Conglomerate	3364	3372
Chat	3372	3375
Red shale	3375	3376
Conglomerate	3376	3383 T.D.