


STATE OF KANSAS
STATE CORPORATION COMMISSION

Form CP-4

WELL PLUGGING RECORD

Give All Information Completely
Make Required Affidavit
Mail or Deliver Report to:
Conservation Division
State Corporation Commission
P. O. Box 17027
Wichita, Kansas 67217
NORTH

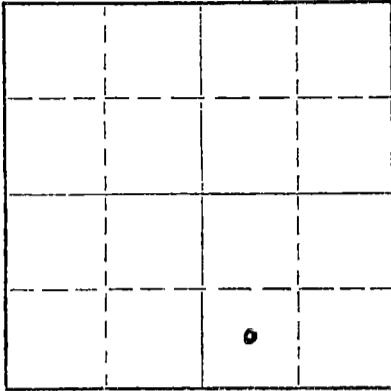

Locate well correctly on above
Section Plat

Rice County. Sec. 10 Twp. 21 Rge. 7 (E) (W) X
Location as "NE/CNW/SW" or footage from lines SW-SE¹/₄ of SE¹/₄
Lease Owner W. R. Allen
Lease Name Yapple Well No. 1
Office Address Drawer E, Haven, Kansas
Character of Well (completed as Oil, Gas or Dry Hole) Oil
Date well completed 8/22/36 19
Application for plugging filed July 29 1975
Application for plugging approved Yes 19
Plugging commenced August 1 1975
Plugging completed October 28 1975
Reason for abandonment of well or producing formation Dry

If a producing well is abandoned, date of last production 19
Was permission obtained from the Conservation Division or its agents before plugging was commenced? Yes

Name of Conservation Agent who supervised plugging of this well Gilbert Toman
Producing formation _____ Depth to top _____ Bottom _____ Total Depth of Well 3381 Feet
Show depth and thickness of all water, oil and gas formations.

OIL, GAS OR WATER RECORDS

CASING RECORD

FORMATION	CONTENT	FROM	TO	SIZE	PUT IN	PULLED OUT
				12 1/2"	116'	None
				7"	3356'	2575'

Describe in detail the manner in which the well was plugged, indicating where the mud fluid was placed and the method or methods used in introducing it into the hole. If cement or other plugs were used, state the character of same and depth placed, from _____ feet to _____ feet for each plug set.

Sand back to 3350'
Dumped six sacks of cement at 3250'
Set rock bridge from 140' to 130'
Filled surface pipe with Ready-Mix concrete

RECEIVED
STATE CORPORATION COMMISSION

DEC 29 1975

CONSERVATION DIVISION
Wichita, Kansas

(If additional description is necessary, use BACK of this sheet)

Name of Plugging Contractor Robert Self
Address R.R. #4 Hutchinson, Kansas 67501

STATE OF Kansas, COUNTY OF Reno, ss.

I Robert Self (employee of owner) or (owner or operator) of the above-described well, being first duly sworn on oath, says: That I have knowledge of the facts, statements, and matters herein contained and the log of the above-described well as filed and that the same are true and correct. So help me God.

(Signature)

R.R. #4 Hutchinson, Kansas 67501
(Address)

SUBSCRIBED AND SWORN TO before me this 28th day of October, 1975

JOLENE G. SELF
Notary Public

Notary Public.

My commission expires

Reno County, Kansas
MY COMM. EXPIRES Jan. 12, 1976

OCT 3 1936

15.159.05392.0000

10-21-76

OPERATOR: The McPherson Drilling Company.

RECORD OF WELL No. 1 YAPLE

File 3-5 W - 5 L - 5 E

LOCATION: Southwest Corner of the Southeast Quarter of the Southeast Quarter (SE $\frac{1}{4}$ of SE $\frac{1}{4}$) Section 20, in Township 21 South, Range 7 West Rice County, Kansas. 10

Pat 6184

Commenced Drilling: June 15th, 1936.

Completed Drilling: July 12th, 1936.

CASING RECORD:

12 $\frac{1}{2}$ "	116 Ft.	Set with 125 Saz Cement.
7" 24# SS	3356 Ft.	Set with 100 Saz Cement.
5-3/16" Liner	30 Ft 3 in.	set at 3364 ft.

LOG.

Surface	12	Broken Lime	2712	
Sand & Gravel	70	Lime & Shale	2826	
Shells	75	Lime	2851	
Red Rock	116	Shale	2883	
Shells	220	Lime	3136	
Red Rock	260	Lime, broken	3268	
Lime Shell	290	Shale	3291	
Shale	600	Broken Lime	3340	
Salt	850	Shale	3353	
Shale	880	Redrock	3394	
Broken Lime	1100	Shale & Sand	3397	
Shale	1312	Standardized:		
Lime	1330	Shale & Sand	3364	
Shale	1360	Conglomerate	3381	Total Depth.
Broken Lime	1480	Potential 6184 bbls.		
Shale	1680			
Lime	1720			
Shale	1905			
Lime	1922			
Shale	1970			
Redrock	1985			
Shale	2025			
Broken Lime	2060			
Shale	2116			
Broken Lime	2136			
Shale	2157			
Broken Lime	2195			
Shale	2295			
Broken Lime	2301			
Shale	2318			
Broken Lime	2585			

RECEIVED
STATE CORPORATION COMMISSION

JUL 29 1975

CONSERVATION DIVISION
Wichita, Kansas