

WELL PLUGGING RECORD

STATE OF KANSAS  
STATE CORPORATION COMMISSION

Give All Information Completely  
Make Required Affidavit  
Mail or Deliver Report to:  
Conservation Division  
State Corporation Commission  
800 Bittling Building  
Wichita, Kansas

OR

FORMATION PLUGGING RECORD

Strike out upper line  
when reporting plug-  
ging off formations.

Rice County, Sec 10 Twp 21 Rge (E) 7 (W)

Location as "NE 1/4 NW 1/4 SW 1/4" or footage from lines NW SE SE

Lease Owner Derby Drilling Company

Lease Name Yanle Well No.

Office Address 352 No. Broadway, Wichita 2, Kansas

Character of Well (completed as Oil, Gas or Dry Hole) Oil Well

Date well completed March 31 19 48

Application for plugging filed 19

Application for plugging approved 19

Plugging commenced October 20 19 48

Plugging completed October 24 19 48

Reason for abandonment of well or producing formation Oil exhausted

If a producing well is abandoned, date of last production 19

Was permission obtained from the Conservation Division or its agents before plugging was commenced? Yes

Name of Conservation Agent who supervised plugging of this well R. Durkee

Producing formation Depth to top Bottom Total Depth of Well 3394 Feet

Show depth and thickness of all water, oil and gas formations.

OIL, GAS OR WATER RECORDS

CASING RECORD

Formation	Content	From	To	Size	Put In	Pulled Out
				10-3/4"	102	NONE
				6"	3368	2871' 7"

Describe in detail the manner in which the well was plugged, indicating where the mud fluid was placed and the method or methods used in introducing it into the hold. If cement or other plugs were used, state the character of same and depth placed, from feet to feet for each plug set.

Rocked hole from 3394' to 3375'. Run 6 sacks of cement  
Mudded hole to 102'. Run 10 sacks of cement.  
Mudded hole to 10'. Run 3 sacks of cement.  
Well completed.

11-8-48 RECEIVED  
NOV 8 1948  
STATE CORPORATION COMMISSION  
KANSAS

(If additional description is necessary, use BACK of this sheet)

Correspondence regarding this well should be addressed to Derby Drilling Company

Address 352 North Broadway, Wichita, Kansas

STATE OF Kansas, COUNTY OF Sedgwick, ss.

M. S. Davis (employee of owner or (owner or operator) of the above-described well, being first duly sworn on oath, says: That I have knowledge of the facts, statements, and matters herein contained and the log of the above-described well as filed and that the same are true and correct. So help me God.


(Signature) M. S. Davis

352 No Broadway Wichita 2, Kansas (Address)

SUBSCRIBED AND SWORN TO before me this 3 day of November, 19 48

My commission expires 12-18-49

Notary Public.

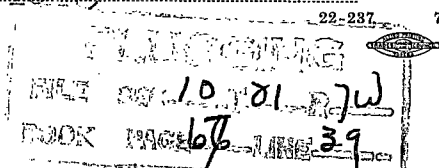

OPERATOR: The McPherson Drilling Company

Well No. 3 Yapple

Location: NW SE SE 10-21 S 7 West Rice County, Kansas

Drilling Commenced: Feb. 2, 1938

Drilling Completed: Mar. 3, 1938

CASING RECORD

10-3/4" Surface Casing	102 Ft.	
6" O.D. 20# S.S. Casing	3368 Ft.	Cemented 100 Sacks Cement.
5 1/2" O.D. Liner	3375 Ft.	Cemented 100 Sacks Cement.

L O G

Surface Sand & Shale	94	
Lime	102	
Lime	108	
Red Rock	136	
Lime	146	
Shale	300	
Broken Lime	480	
Shale	550	
Broken Lime	585	
Salt & Shale	845	
Broken Lime	1260	
Sandy Lime	1330	
Broken Lime	1355	
Shale	1370	
Lime, broken	1550	
Red Rock	1560	
Broken Lime	1595	
Shale	1626	
Broken Lime	1738	
Shale	1907	
Broken Lime	1942	
Shale	1995	
Lime	2005	
Shale	2100	
Broken Lime	2471	
Lime	2502	
Broken Lime	2548	
Lime	2735	
Shale	2750	
Sandy Shale	2765	
Broken Lime	2857	
Shale	2887	
Lime	3310	
Shale	3359	
Lime	3362	
Red Rock	3368	
Conglomerate	3372	
Red Rock	3375	
Conglomerate	3394	Total Depth

Initial Production on 15 Bbls. Min.

RECORDED  
 NOV 8 1938  
 STATE REGISTRATION  
 COMMISSION  
 KANSAS

**PLUGGING**  
 FILE NO. 10-21 S 7 W  
 67 39