

STATE OF KANSAS
STATE CORPORATION COMMISSION


WELL PLUGGING RECORD

Give All Information Completely
Make Required Affidavit
Mail or Deliver Report to:
Conservation Division
State Corporation Commission
800 Bitting Building
Wichita, Kansas

OR
FORMATION PLUGGING RECORD

Strike out upper line
when reporting plug-
ging of formations.

Rice County. Sec. 10 Twp 21S Rge 7W (W)
Location as "NE $\frac{1}{4}$ NW $\frac{1}{4}$ SW $\frac{1}{4}$ " or footage from lines. NEC SW SE
Lease Owner S. M. Kantor
Lease Name Afie Hauschild Well No. 3
Office Address Box 846, Tulsa, Oklahoma
Character of Well (completed as Oil, Gas or Dry Hole) Abandoned Oil Well
Date well completed 19.
Application for plugging filed June 13, 1945
Application for plugging approved July 2, 1945
Plugging commenced 19.
Plugging completed July 16, 1945
Reason for abandonment of well or producing formation Oil depleted

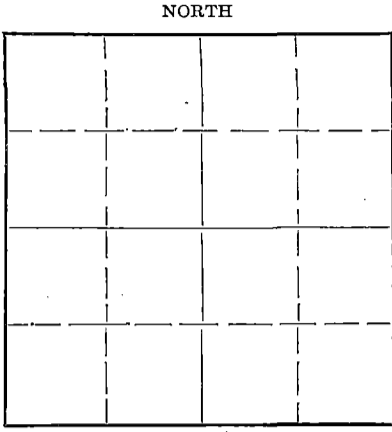

Locate well correctly on above
Section Plat

If a producing well is abandoned, date of last production 19.
Was permission obtained from the Conservation Division or its agents before plugging was com-
menced? Yes
Ruel Durkee

Name of Conservation Agent who supervised plugging of this well
Producing formation Depth to top Bottom Total Depth of Well 337.9 Feet
Show depth and thickness of all water, oil and gas formations.

OIL, GAS OR WATER RECORDS

CASING RECORD

Formation	Content	From	To	Size	Put In	Pulled Out

Describe in detail the manner in which the well was plugged, indicating where the mud fluid was placed and the method or methods used in introducing it into the hole. If cement or other plugs were used, state the character of same and depth placed, from feet to feet for each plug set.

Hole made solid at 3369 feet and 6
sacks of cement dumped at 3369 feet.
Hole made solid at 150 feet and 20
sacks of cement dumped at 150 feet.
5 sacks of cement dumped at top of
surface pipe.
Intervals between plugs were mudded
with heavy mud.

(If additional description is necessary, use BACK of this sheet)


Correspondence regarding this well should be addressed to S. M. Kantor,
Address 8 Box 846, Tulsa, Oklahoma

STATE OF Oklahoma COUNTY OF Tulsa, ss.
S. M. Kantor (employee of owner) or (owner or operator) of the above-described well,
being first duly sworn on oath, says: That I have knowledge of the facts, statements, and matters herein contained and the log of the above-
described well as filed and that the same are true and correct. So help me God.

(Signature) [Signature]
P. O. Box 846 - Tulsa Okla (Address)

SUBSCRIBED AND SWORN to before me this 22nd day of June, 1948
L. R. [Signature] Notary Public.

My commission expires Jan 14, 1952

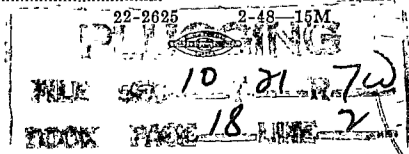

b-23-48