


WELL PLUGGING RECORD

Give All Information Completely
Make Required Affidavit
Mail or Deliver Report to:
Conservation Division
State Corporation Commission
800 Blitting Building
Wichita, Kansas

STAFFORD County. Sec. 20 Twp. 21 Rge. 12 ~~12~~ (W)

Location as "NE/CNW $\frac{1}{4}$ SW $\frac{1}{4}$ " or footage from lines NE SE NW
Lease Owner Musgrove Petroleum Corporation
Lease Name CARROLL Well No. 2
Office Address 407 KFH Building, Wichita 2, Kansas
Character of Well (completed as Oil, Gas or Dry Hole) OIL

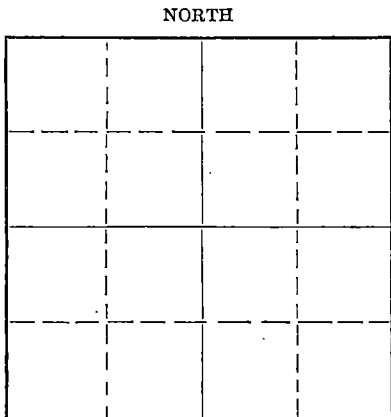

Locate well correctly on above Section Plat

Date well completed October 18, 19 49
Application for plugging filed February 14, 19 51
Application for plugging approved February 15, 19 51
Plugging commenced August 7, 19 51
Plugging completed August 24, 19 51
Reason for abandonment of well or producing formation Dry

If a producing well is abandoned, date of last production February 15, 19 51
Was permission obtained from the Conservation Division or its agents before plugging was commenced? YES

Name of Conservation Agent who supervised plugging of this well C. D. Stough

Producing formation Depth to top Bottom Total Depth of Well 3577' Feet

Show depth and thickness of all water, oil and gas formations.

OIL, GAS OR WATER RECORDS

CASING RECORD

Formation	Content	From	To	Size	Put In	Pulled Out
				5 $\frac{1}{2}$ "	3564 $\frac{1}{2}$ '	2830.89'

Describe in detail the manner in which the well was plugged, indicating where the mud fluid was placed and the method or methods used in introducing it into the hole. If cement or other plugs were used, state the character of same and depth placed, from feet to feet for each plug set.

Filled hole, with chat, from 3577' to 3450'. Dumped 5 sacks cement at 3450', with dump bailor.
Shot off and pulled, 2830' of 5 $\frac{1}{2}$ " pipe.
Mudded hole to 300'. Set 15' rock bridge, at 300'.
Dumped 20 sacks cement at 285'.
Mudded hole to 35'. Set 10' rock bridge at 35'.
Dumped 10 sacks cement, to fill and cap top of surface pipe.

(If additional description is necessary, use BACK of this sheet)

Name of Plugging Contractor Musgrove Petroleum Corporation
Address 407 KFH Building, Wichita 2, Kansas

STATE OF KANSAS, COUNTY OF SEDGWICK, ss.
Gordon L. Koelling (employee of owner) or (owner or operator) of the above-described well, being first duly sworn on oath, says: That I have knowledge of the facts, statements, and matters herein contained and the log of the above-described well as filed and that the same are true and correct. So help me God.

(Signature) Gordon L. Koelling
407 KFH Building (Address)

SUBSCRIBED AND SWORN to before me this 26th day of October, 19 51.

My commission expires July 9, 1952

RECEIVED
STATE CORPORATION COMMISSION
028-8390-8 6-51-20M

Mary Lou Hayes Notary Public

PLUGGING
FILE SEC-20 Twp 21 Rge 12
BOOK PAGE 66 LINE 38
10-27-51

WELL LOG

MINERAL PRODUCTION CORPORATION

Carroll #2, 22 05 117

Stafford County, Kansas

0	235	Sand
235	339	Sand & Red Bed
339	445	Red Bed & shales
445	674	Red Bed & shales
674	700	Anhydrite
700	1035	Shale & shales
1035	1275	Shale & shales
1275	1300	Shale & shales
1300	1400	Salt
1400	1525	Shale & shales
1525	1650	Line
1650	1750	Shale & line
1750	1850	Shale & line
1850	2000	Brown line & shale
2000	2175	Shale & line
2175	2275	Shale & line
2275	2340	Shale & line
2340	2400	Shale
2400	2615	Shale
2615	2750	Shale & line
2750	2840	Shale & line
2840	2850	Shale & line
2850	2921	Line
2921	3011	Line
3011	3088	Line
3088	3152	Line
3152	3211	Shale & line
3211	3252	Shale
3252	3290	Line
3290	3342	Line
3342	3385	Line
3385	3425	Line
3425	3478	Line
3478	3525	Line
3525	3565	Shale
3565	3590	Line (irregular)
3590		TOTAL DEPTH

COMPLETED: 10/3/49
CORRECTED: 10/10/49

CASING NOTES

2-5/8" surface casing set at 335' cemented w/25 sacks cement by Cox Oil-Well Casing Co.

5-1/2" casing set at 359', cemented with 75 sacks cement.

RECEIVED
STATE CORPORATION COMMISSION
FEB 15 1951
CONSERVATION DIVISION
Wichita, Kansas

STATE OF KANSAS }
CITY OF WICHITA } SS

I hereby affirm that the above and foregoing is a true and correct copy of the log of the Carroll #2, 22 05 117, Stafford County, Kansas.

MINERAL PRODUCTION CORPORATION, INC.

By: H. E. Jensen
H. E. Jensen
Assistant Secretary

Subscribed and sworn to before me, a Notary Public, this 22nd day of October, 1949.

Marilyn Gage
Notary Public

My commission expires September 13, 1950

PLUGGING
FILE SEC 20 T 27 R 12 W
BOOK PAGE 61 LINE 38