


WELL PLUGGING RECORD

Give All Information Completely
Make Required Affidavit
Mail or Deliver Report to:
Conservation Division
State Corporation Commission
211 No. Broadway
Wichita, Kansas

NORTH

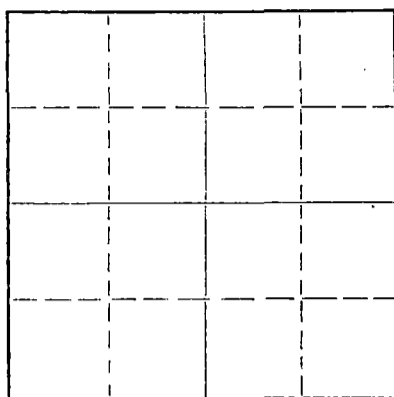

Locate well correctly on above
Section Plat

Stafford County. Sec. 20 Twp. 21S Rge. 12W (E) (W)
Location as "NE/CNW*SW*" or footage from lines. SE NW SE
Lease Owner K & E DRILLING, INC. & CENTURY PRODUCTION CO.
Lease Name Tieperman Well No. 1
Office Address 719 Union Center Building, Wichita, Kansas
Character of Well (completed as Oil, Gas or Dry Hole) Dry Hole
Date well completed 11-6-56 19
Application for plugging filed 11-6-56 19
Application for plugging approved 11-6-56 19
Plugging commenced 11-6-56 19
Plugging completed 11-6-56 19
Reason for abandonment of well or producing formation

If a producing well is abandoned, date of last production 19
Was permission obtained from the Conservation Division or its agents before plugging was commenced? yes

Name of Conservation Agent who supervised plugging of this well Eldon Petty
Producing formation _____ Depth to top _____ Bottom _____ Total Depth of Well 3615 Feet
Show depth and thickness of all water, oil and gas formations.

OIL, GAS OR WATER RECORDS

CASING RECORD

FORMATION	CONTENT	FROM	TO	SIZE	PUT IN	PULLED OUT
				8-5/8	290/	

Describe in detail the manner in which the well was plugged, indicating where the mud fluid was placed and the method or methods used in introducing it into the hole. If cement or other plugs were used, state the character of same and depth placed, from _____ feet to _____ feet for each plug set.

#1 Plug at 270' w/20 sx cmt. Plug #2 at 35' with 10
sx cement & 3/4 sack hulls. Filled to surface.
Plugging completed.

(If additional description is necessary, use BACK of this sheet)

Name of Plugging Contractor K & E DRILLING, INC.
Address 719 Union Center Building, Wichita, Kansas

STATE OF Kansas, COUNTY OF Sedgwick, ss.
Dale Silcott (employee of owner) or (owner or operator) of the above-described well, being first duly sworn on oath, says: That I have knowledge of the facts, statements, and matters herein contained and the log of the above-described well as filed and that the same are true and correct. So help me God!

(Signature) Dale Silcott
K & E DRILLING, INC., 719 Union Center, Wichita, Kansas
(Address)

SUBSCRIBED AND SWORN TO before me this 13th day of November, 19 56

My commission expires 11 August 1958.

Patricia M. Edwards, Notary Public.

PLUGGING
FILE SEC. 20 T. 21 R. 12W
BOOK PAGE 114 LINE 18

NOV 14 1956
CONSERVATION DIVISION
Wichita, Kansas

W E L L L O G

15.185.00328.0000

OPERATOR: K & E DRILLING, INC. AND
CENTURY PRODUCTION COMPANY
719 UNION CENTER BUILDING
WICHITA, KANSAS

FARM NAME: #1 TIEPFRMAN
LOCATION: SE NW SE
20-218-12W
Stafford County
Kansas

CONTRACTOR: K & E DRILLING, INC.
719 Union Center Building
Wichita, Kansas

CASING RECORD: 6-5/8" set at 290 (240 fm)

COMMENCED: 10-29-56
COMPLETED: 11-6-56

R.T.D.: 3615'

PRODUCTION: D & A

D & A

FORMATION RECORD

Depths shown indicate bottom of formations

Sand	235
Shale	670
Anhydrite	695
Shale & Shells	735
Shale & Red Bed	1335
Shale & Shells	1495
Lime	2140
Lime & Shale	2165
Lime	2235
Lime & Shale	2333
Shale	2550
Lime & Shale	3005
Lime	3133
Shale	3235
Lime	3500
Lime & Shale	3560
Conglomerate	3580
Chert	3605
Cherty Lime	3615
R.T.D.	3615

CERTIFICATION

STATE OF KANSAS)
) SS:
COUNTY OF SEDGWICK)

I, Dale Silcott of the K & E DRILLING, INC., upon oath state that the above and foregoing is a true and correct copy of the log of the #1 Tiepferman well.

Dale Silcott
Dale Silcott

Subscribed and sworn to before me this 27th day of November, 1956

Patricia M. Edwards
Patricia M. Edwards, Notary Public

My commission expires: 11 August 1958.

PLUGGING
FILE SEC 20 T 21 R 12W
BOOK PAGE 114 LINE 18

RECEIVED
STATE CONSERVATION COMMISSION
JAN 1 1957
CONSERVATION DIVISION
Wichita, Kansas