

STATE OF KANSAS
STATE CORPORATION COMMISSION


WELL PLUGGING RECORD

OR
FORMATION PLUGGING RECORD

Strike out upper line
when reporting plug-
ging off formations.

Give All Information Completely
Make Required Affidavit
Mail or Deliver Report to:
Conservation Division
State Corporation Commission
800 Bitting Building
Wichita, Kansas

Stafford County. Sec. 20 Twp. 21 Rge. (B) 12 (W)
Location as "NE 1/4 NW 1/4 SW 1/4" or footage from lines. C5/2 NE-SW
Lease Owner. Sunray Oil Corporation
Lease Name. Lacy Well No. 1
Office Address. B ox 195 Great Bend, Kansas
Character of Well (completed as Oil, Gas or Dry Hole) Dry Hole
Date well completed. May 20 1945
Application for plugging filed. May 21 1945
Application for plugging approved. 19
Plugging commenced. May 20 1945
Plugging completed. May 20 1945
Reason for abandonment of well or producing formation. Dry Hole
If a producing well is abandoned, date of last production. 19
Was permission obtained from the Conservation Division or its agents before plugging was com-
menced? Yes

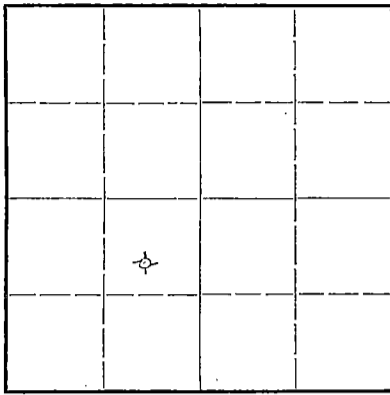

Locate well correctly on above
Section Plat

Name of Conservation Agent who supervised plugging of this well. Mr H.W. Kerr
Producing formation. Depth to top. 3842 Bottom. 3900 Total Depth of Well. 3900 Feet
Show depth and thickness of all water, oil and gas formations.

OIL, GAS OR WATER RECORDS

CASING RECORD

Formation	Content	From	To	Size	Put In	Pulled Out
Arbuckle	Water	3842	3900	10 3/4	275	None


Describe in detail the manner in which the well was plugged, indicating where the mud fluid was placed and the method or methods used in introducing it into the hold. If cement or other plugs were used, state the character of same and depth placed, from _____ feet to _____ feet for each plug set.

275' 10 3/4 Surface Casing Set and cemented with 207 s.f. cement circulated.
Hole bridged at 250' with wood plug. 20 sacks cement placed from 250' to 215'. Filled with heavy mud from 215' to 15'.
Hole bridged with wood plug and filled with 15 sacks, cement to surface.

PLUGGING
20 21 12W
13 25

(If additional description is necessary, use BACK of this sheet)

Correspondence regarding this well should be addressed to Sunray Oil Corporation
Address. Box 195 Great Bend, Kansas

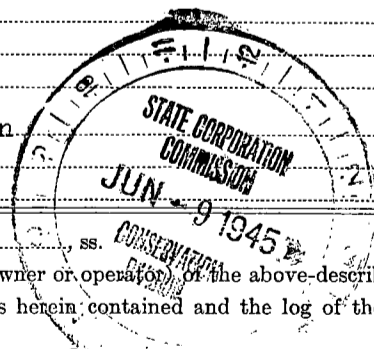

STATE OF _____, COUNTY OF _____
(employee of owner) or (owner or operator) of the above-described well,
being first duly sworn on oath, says: That I have knowledge of the facts, statements, and matters herein contained and the log of the above-described well as filed and that the same are true and correct. So help me God.

(Signature) Fred M. Davis
Box 195 Great Bend, Kansas
(Address)

SUBSCRIBED AND SWORN TO before me this 29th day of May, 1945

My commission expires May 10, 1948
Anna Niedens
Notary Public.

Sunray Oil Corporation
Tulsa, Oklahoma

15.185.11757.0000

Lacy Well No. 1

S/2 NE/4 SW/4
Sec. 20-21S-12W
Stafford County, Kansas

Contractor: The R. W. Rine Drilling Company
Commenced: May 5, 1945

Completed: May 21, 1945

LOG	
Sand & Gravel	0- 230
Shale & Shells	230- 255
Shale & Red Bed	255- 275
Red Bed & Shale	275- 465
Shale & Shells	465-1090
Salt & Shale	1090-1270
Shale	1270-1530
Anhydrite	1530-1550
Lime	1550-1620
Shale & Lime	1620-1860
Shale, Shells, & Lime	1860-1980
Shale & Lime	1980-2350
Shale	2350-2660
Shale & Lime	2660-2970
Lime	2970-2990
Shale	2990-3025
Lime	3025-3210
Lime & Shale	3210-3355
Lime	3355-3415
Lime & Shale	3415-3515
Lime	3515-3565
Conglomerate	3565-3699
Shale	3699-3775
Conglomerate	3775-3780
Lime & Chert	3780-3807
Shale & Lime	3807-3869
Lime	3869-3900

10 3/4" casing cemented @ 275'

Total Depth 3900'

State of Kansas)
County of Barton) ss.

I, Clyde W. Goddard, do hereby certify that the above is a true and complete log of the Lacy Well No. 1, located in the S/2 of the NE/4 of the SW/4 of Section 20, Township 21S, Range 12W, in Stafford County, Kansas.

Clyde W. Goddard

Sworn to and subscribed before me this 23rd day of May, 1945.

Eileen G. Williams
Notary Public

My commission expires Dec. 6, 1948

20 21 12W
13 25